

Section 28 Township 17 Range 9WWell No. #1 RolfsCompany Heathman Oil

NORTH

14

SOUTH

EAST

WEST

0

Ellsworth

KANSAS

Sec. 28 Twp. 17 R. 9W

Well No. #1 Rolfs Farm

Heathman Oil Company

B & B Drlg. - Contr. Contractor

Stoltenberg Pool


Ft. from N. Line

330' Ft. from S. Line

330' Ft. from E. Line

Ft. from W. Line

SE SE SW

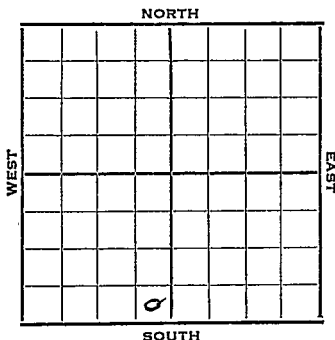

1951 Elev. 1756' REPORT

12/12 Spud 12-10-51
8" @ 218
WO

1952
1/2 Spud 12-10-51
D&A TD 3289
8" @ 218
Anhy 415
Heeb. 2753
Cong. 3205
Arb. 3268
TD 3289
D&A

Top. 2486
Lans. 2887
Simp. 3257

ABANDONED


County Ellsworth State KansasSec. 28 (Blk. 17) (Sur. 9W) Map No.Operator Heathman OilWell No. 1 Farm RolfsElev. Location SE SE SW330 Ft. From S Line SW330 Ft. From E Line Quarter1st. Report DEC 1 2 1951

Completion

Remarks

B & B Drlg. - Contr.Spudding Date 12-10-51Drlg. Data Stoltenberg Pool8" @ 218 WOCJ. E. TYRA

County Ellsworth State Kansas
 Sec. 28 (Blk.) 17 (Sur.) 9W Map No.
 Operator Heathman & Co.
 Well No. 1 Farm Rolfs
 Elev. 1756 Location SE SE SW

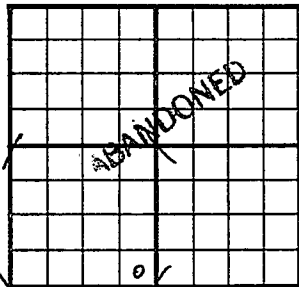

330 Ft. From S Line SW
330 Ft. From E Line Quarter
 1st. Report
 Completion JAN 2 1952
 Remarks Stoltenberg Pool
B & B Drlg. - Contr.
 Spudding Date 12-10-51

Drlg. Data D & A TD 3289
8" @ 218 Anhy 415 Top. 2486 Heeb. 2753
Lans. 2887 Cong. 3205 Simp. 3257
Arb. 3268 TD 3289

D & A

J. E. TYRA