


Section 28 -- Township 17 Range 8-W

Well No. #1 Fuller


Company Continental et al

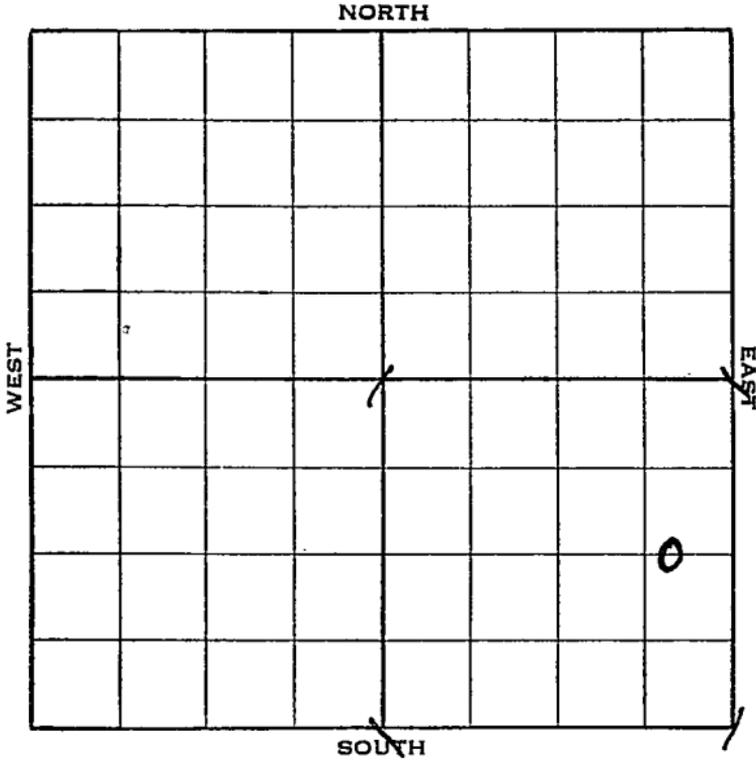

Sec. 28 Twp. 17 R. 8-W

Well No. #1 Fuller Farm _____
Continental et al Company

_____ Ft. from N. Line
1320 Ft. from S. Line
440 Ft. from E. Line
 _____ Ft. from W. Line
 Elev. 1777

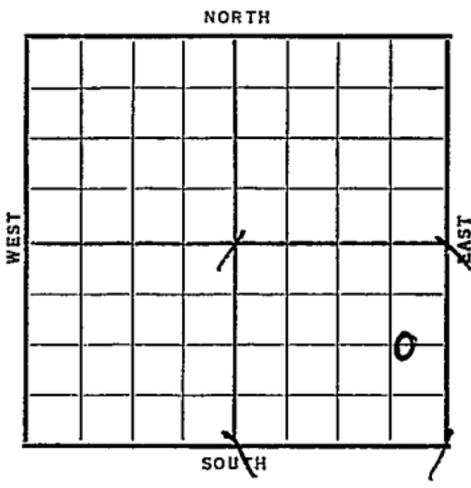

Date	REPORT
1938	
10/19	B.R.R.
10/28	10" - 203'. Dlg. 570'.
11/4	Dlg. 2872'.
11/12	Arb. 3174'-89'. 7" - 3176'. RUST
11/18 -	T. D. 3232'. 3100' oil.
	SD tanks.
11/25	" " "
12/2	" " "
12/7	7" - 3176'.
	Arb. 3174'.
	T. D. 3232'.
	Pump 592 bbls. 8 hours.
	Potential 1776 bbls., Nat'l.
	COMPLETED

Map No. _____ Sec. 28 Twp. 17 R. 8WWell No. 1 FullerContinental etal Company

Contractor

FIRST REPORT


C E L S E

_____ Ft. from N. Line

1320 Ft. from S. Line440 Ft. from E. Line

_____ Ft. from W. Line

SECTION PLAT

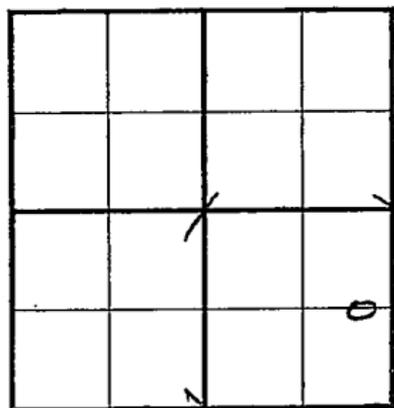

Location _____

Rig up _____

Drilling and Remarks:

BRR

RECORD

Cased _____ in., _____ ft.

Sand _____

Gas _____

Oil _____

Total Depth _____

PRODUCTION

1st 24 hrs. Nat. _____

1st 24 hrs. after shot _____

Gas _____ Cu. Ft.

Dry Hole _____

Abandoned _____

Date

OCT 19 1938₁₉H. D. Hatfield Scout

