


Ellsworth

KANSAS

Form 51—5M—11-38—Palace

Section 28 Township 17 Range 8-WWell No. 2 FullerCompany Continental et al

NORTH Edwards Pool

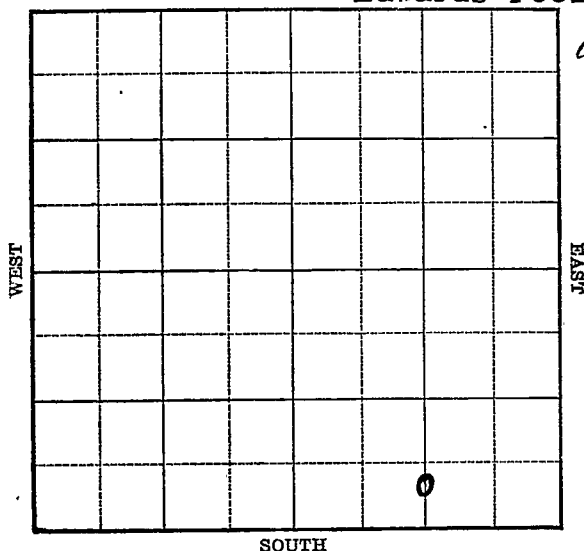

Ellsworth KANSAS

Map No. _____ Sec. 28 Twp. 17 R. 8WWell No. 2 FullerContinental etal Company

Contractor

FIRST REPORT

C S L SE

_____ Ft. from N. Line

440 Ft. from S. Line1320 Ft. from E. Line

_____ Ft. from W. Line

EDWARDS POOL

SECTION PLAT

Location _____

Rig up _____

Drilling and Remarks:

BRR

RECORD

Cased _____ in., _____ ft.

Sand _____

Gas _____

Oil _____

Total Depth _____

PRODUCTION

1st 24 hrs. Nat. _____

1st 24 hrs. after shot _____

Gas _____ Cu. Ft.

Dry Hole _____

Abandoned _____

Date

FEB 1 - 1939 19

H. D. Hatfield Scout

Map No. 45 Sec. 28 Twp. 17 R. 8WWell No. 2 FullerContinental etal Company

Contractor

COMPLETED

C S L SE

Ft. from N. Line

440 Ft. from S. Line1320 Ft. from E. Line

Ft. from W. Line

EDWARDS POOL

SECTION PLAT

			0

Location _____

Rig up _____

Drilling and Remarks:

*2000 Acid**P. 74 1/8**POT 2222***RECORD**Cased 7 in., 3182 ft.Sand Arb 3181

Gas _____

Oil _____

Total Depth 3233**PRODUCTION**

1st 24 hrs. Nat. _____

1st 24 hrs. after shot _____

Gas _____ Cu. Ft.

Dry Hole _____

Abandoned _____

Date

MAR 15 1939 19 H. D. Hatfield Scout