

KANSAS


Form 51-5M-7-40-Palace

Ellsworth

Section 28 Township 17 Range 8-W

Well No. #5 Fuller

Company Continental et al

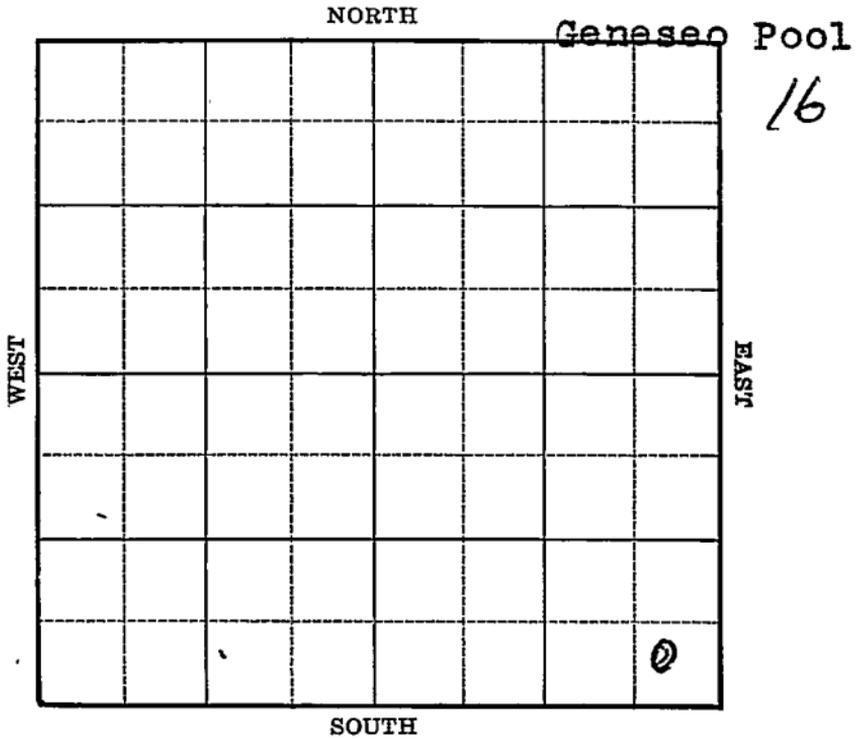

Sec. 28 Twp. 17 R. 8-W

Well No. #5 Fuller Farm

Continental et al

Company

(Geneseo)


_____ Ft. from N. Line

515 Ft. from S. Line

440 Ft. from E. Line

_____ Ft. from W. Line

Elev. 1779

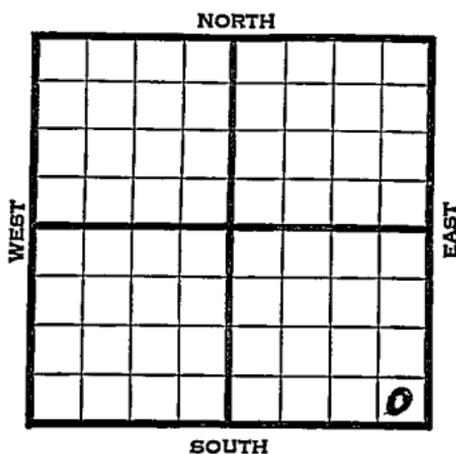

1941	REPORT
2/19	10" - 207' WOC.
2/27	Drlg. 2520'
3/6	Arb. 3178-83' T.D. 6" - 3179' RUST.
3/13	T.D. 3229' Swab 120 bbls. oil 1½ hours.
3/19	Arb. 3178'
	6" - 3179'
	T.D. 3229'
	Echometer potential 6588 bbls.
	Maximum 3000 bbls.
	40.1 Gravity
	COMPLETED

Map No. 45 Sec. 28 Twp. 17 R. 8WWell No. 5 FullerContinental etal Company

Contractor

FIRST REPORT

SE/C

 Ft. from N. Line515 Ft. from S. Line440 Ft. from E. Line Ft. from W. Line

GENESEO POOL

SECTION PLAT

			o

Location Rig up

Drilling and Remarks:

10" - 207

WOC

RECORDCased in., ft.Sand Gas Oil Total Depth **PRODUCTION**1st 24 hrs. Nat. 1st 24 hrs. after shot Gas Cu. Ft.Dry Hole Abandoned

Date

FEB 19 1941

19

S. J. LEWIS Scout

Map No. 45 Sec. 28 Twp. 17 R. 8W

Well No. 5 Fuller

Continental etal Company

~~COMPLETED~~ Contractor

SE/C

SECTION PLAT

_____ Ft. from N. Line

515 Ft. from S. Line

440 Ft. from E. Line

_____ Ft. from W. Line

GENESEO POOL

Location _____

Rig up _____

Drilling and Remarks:

Core # 3178
6" CB179
Echo # 6588
May 8000
40' SW

RECORD

Cased _____ in., _____ ft.

Sand _____

Gas _____

Oil _____

Total Depth 3229

PRODUCTION

1st 24 hrs. Nat. _____

1st 24 hrs. after shot _____

Gas _____ Cu. Ft.

Dry Hole _____

Abandoned _____

Date

MAR 10 1941 19

S. I. LEWIS Scout