

Sec. 28 Twp. 17 R. 8-W

Well No. #4 O. Fuller Farm

Continental et al Company


(Geneseo)

440 Ft. from N. Line

_____ Ft. from S. Line

440 Ft. from E. Line

_____ Ft. from W. Line

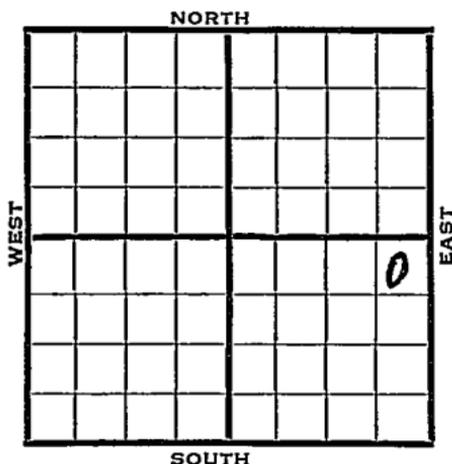

Elev. 1777

1940	REPORT
5/22	Derrick.
5/29	10" - 208' Drlg. 1475'
6/6	Arb. 3182-85' T.D. 7" - 3183' RUST.
6/13	3192' - 1600' 3 hours. 3215' - 3100' oil. T.D. 3226' Run tubing.
6/19	Arb. 3182' 7" - 3183' T.D. 3226' 2000 acid. Echometer potential 5377 bbls. Maximum 3000 bbls.
COMPLETED	

Map No. 45 Sec. 28 Twp. 17 R. 8WWell No. 4 O. FullerContinental etal Company

Contractor

FIRST REPORT

NE SE

440 Ft. from N. Line

_____ Ft. from S. Line

440 Ft. from E. Line

_____ Ft. from W. Line

SECTION PLAT

			o

GENESEO POOL

Location _____

Rig up _____

Drilling and Remarks:

Derrick

RECORD

Cased _____ in., _____ ft.

Sand _____

Gas _____

Oil _____

Total Depth _____

PRODUCTION

1st 24 hrs. Nat. _____

1st 24 hrs. after shot _____

Gas _____ Cu. Ft.

Dry Hole _____

Abandoned _____

Date

MAY 22 1940 19

S. J. LEWIS Scout

Map No. 45 Sec. 28 Twp. 17 R. 8W

Well No. 4 O. Fuller

Continental etal

Company

Contractor

COMPLETED

SECTION PLAT

440 NE SE Ft. from N. Line

_____ Ft. from S. Line

440 Ft. from E. Line

_____ Ft. from W. Line

			o

GENESEO POOL

Location _____

Rig up _____

Drilling and Remarks:

Ar 83182
7" C 3183
2000 acid
Estimated P & X
5377
May 3000

RECORD

Cased _____ in., _____ ft.

Sand _____

Gas _____

Oil _____

Total Depth 3226

PRODUCTION

1st 24 hrs. Nat. _____

1st 24 hrs. after shot _____

Gas _____ Cu. Ft.

Dry Hole _____

Abandoned _____

Date

JUN 19 1940 19

S. J. LEWIS Scout