


Section 28 Township 17 Range 8W

Well No. 1 Johnson

Company J. L. Chew

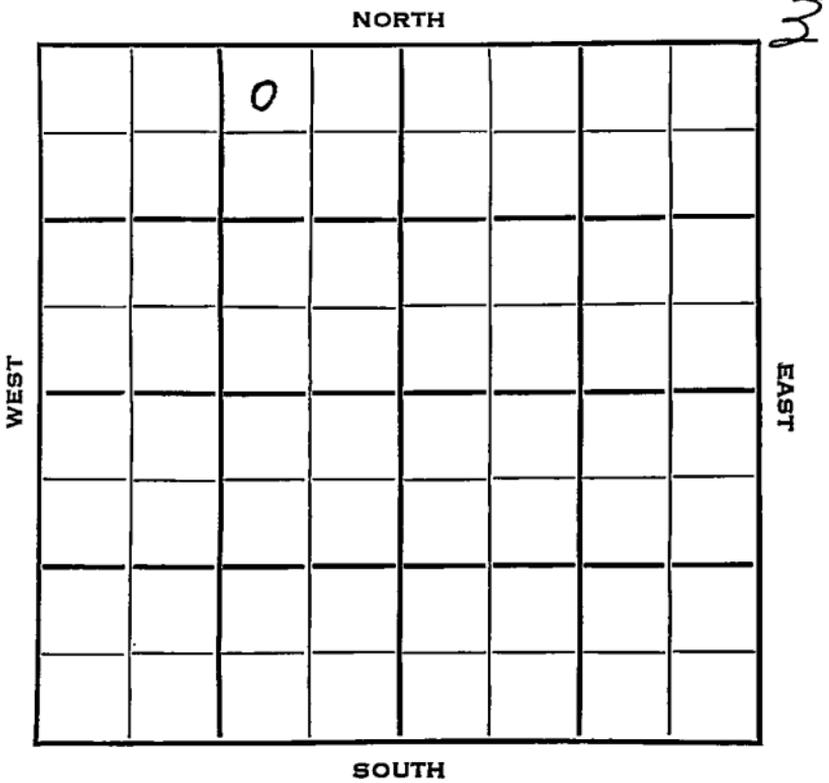

Ellsworth KANSAS

SEC.	TWP.	R.
28	17	8W ✓

WELL NO. 1 Johnson FARM

COMPANY J. L. Chew

CONTRACTOR Stag Drlg.


Edwards Pool

330 Ft. from N. Line

\_\_\_\_\_ Ft. from S. Line

990 Ft. from E. Line

\_\_\_\_\_ Ft. from W. Line

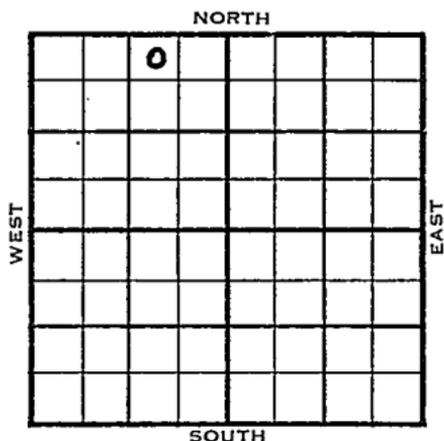

NW NE NW  
Cont'l & CSO Farmout

	ELEVATION	REPORT
1954	1791'	

1/13	MIM	
1/20	8" @ 210' Drlg. 700'	
1/27	Drlg. 3085'	
2/3	Spud 1-13-54 D&A TD 3370' 8" @ 210' Heeb 2731', Br lime 2850', Lans 2872', B KC 3184', Cong 3223', Viola 3255', Simp 3290', Arb. 3331' DST 3333-35', opn 1 hr., rec. 195' wtr, 650# DST 3340-45', opn 1 hr., rec. 510' wtr, TD 3370' D&A	

**ABANDONED**


County **Ellsworth** State **Kansas**

Sec. **28** (Blk. Twp.) **17** (Sur. Rge.) **8W** Map No.

Operator **J. L. Chew**

Well No. **1** Farm **Johnson**

Elev. Location **NW NE NW**

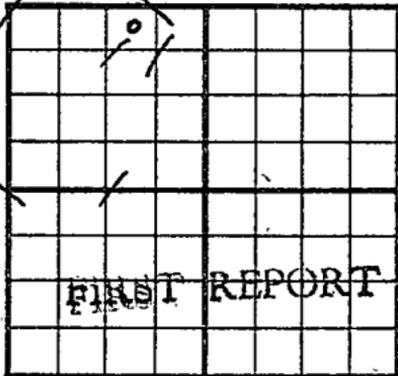

**330** Ft. From **N** Line **NW**

**990** Ft. From **E** Line Quarter

lst. Report. **JAN 13 1954**

Completion

Remarks **Cont'l & CSO farmout**

**Stag Drlg. - Contr.**

Spudding Date

Drlg. Data **Edwards Pool**

**M I M**


County Ellsworth State Kansas

Sec. 28 (Blk. Twp.) 17 (Sur. Rge.) 8W Map No.

Operator J. L. Chew

Well No. 1 Farm Johnson

Elev. 1791 Location NW NE NW

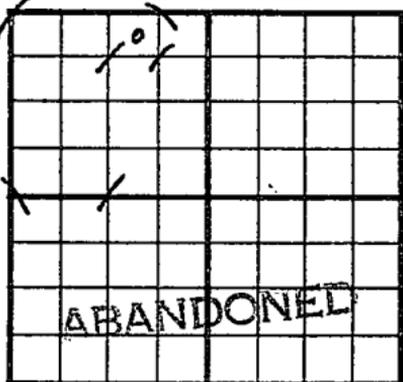

330 Ft. From N Line NW

990 Ft. From E Line Quarter

1st. Report

Completion FEB 3 1954

Remarks Edwards Pool

Stag Drlg. - Contr.

Spudding Date 1-13-54

Drlg. Data D & A TD 3370

8" @ 210 Heeb. 2731 Br. line 2850

Lans. 2872 B KC 3184 Cong. 3223

Viola 3255 Simp. 3290 Arb. 3331

DST 3333-35 open 1 hr. Rec. 195' wtr.

650# DST 3340-45 open 1 hr. Rec.

510' wtr. TD 3370

D & A

J. G. McGEHEE