

KANSAS


Form 51-5M-7-40-Palace

Ellsworth

Section 28 Township 17 Range 8-W

Well No. #3 Johnson "A"

Company Continental

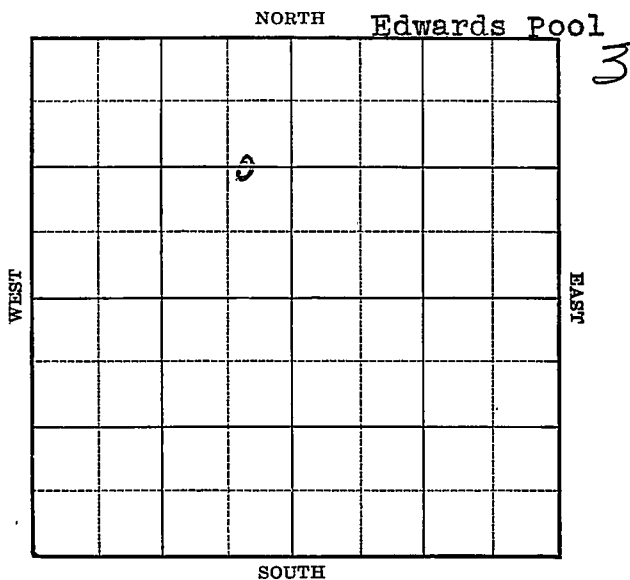

KANSAS


Ellsworth

Sec. 27 28 Twp. 17 R. 8-WWell No. #3 Johnson "A" FarmContinental et al Company

(Edwards)

1320 Ft. from N. Line Ft. from S. Line440 Ft. from E. Line Ft. from W. Line

Elev. 1780

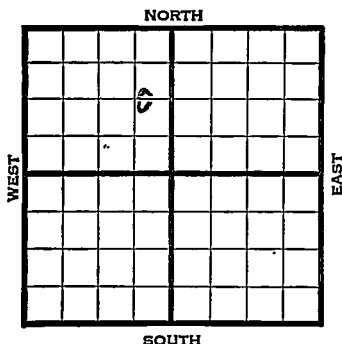

1940 *

REPORT

10/9

Derrick.

10/17

10" - 197'

Drlg. 1165'

10/24

Drlg. 3095'

10/31

Arb. 3255' 6" - 3256'

T.D. 3257' RUST.

11/6

Arb. 3255'

6" - 3256'

T.D. 3258'

1000 acid.

Echometer potential 823 bbls.

COMPLETED

Map No. 43 Sec. 28 Twp. 17 R. 8WWell No. 3 Johnson "A"Continental etal CompanyCORRECTION Contractor**SECTION PLAT**

C E L NW

1320 Ft. from N. Line Ft. from S. Line440 Ft. from E. Line Ft. from W. Line**EDWARDS POOL**

Location Rig up

Drilling and Remarks:

Reported

27-17-18W**RECORD**Cased in., ft.Sand Gas Oil Total Depth **PRODUCTION**1st 24 hrs. Nat. 1st 24 hrs. after shot Gas Cu. Ft.Dry Hole Abandoned

Date

OCT 10 1940 19S. J. LEWIS Scout

Map No. _____ Sec. 27 Twp. 17 R. 8WWell No. 3 Johnson "A"

_____ Continental etal _____ Company

_____ Contractor

FIRST REPORT

C E L NW

1320 Ft. from N. Line

_____ Ft. from S. Line

440 Ft. from E. Line

_____ Ft. from W. Line

EDWARDS POOL

SECTION PLAT

Location _____

Rig up _____

Drilling and Remarks:

Derrick

RECORD

Cased _____ in., _____ ft.

Sand _____

Gas _____

Oil _____

Total Depth _____

PRODUCTION

1st 24 hrs. Nat. _____

1st 24 hrs. after shot _____

Gas _____ Cu. Ft.

Dry Hole _____

Abandoned _____

Date

OCT 9 1940 19S. J. LEWIS Scout

Map No. 45 Sec. 28 Twp. 17 R. 8WWell No. 3 Johnson "A"Continental etal

Company


Contractor

COMPLETED

C E L NW

1320 Ft. from N. Line Ft. from S. Line440 Ft. from E. Line Ft. from W. Line

EDWARDS POOL

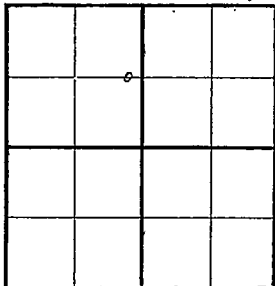SECTION PLATLocation Rig up

Drilling and Remarks:

*Cor. 3255**6" @ 3256**1000 acid**Echo Pot 823***RECORD**Cased in., ft.Sand Gas Oil Total Depth 3255**PRODUCTION**1st 24 hrs. Nat. 1st 24 hrs. after shot Gas Cu. Ft.Dry Hole Abandoned

Date

NOV 6 1940

S. J. LEWIS Scout