

KANSAS

FORM 51 5M 4-41 PETROL

Ellsworth

Section 28 Township 17- Range 8-W

Well No. #2 Kuhnle


Company Continental et al

Edwards pool

NORTH

WEST

EAST

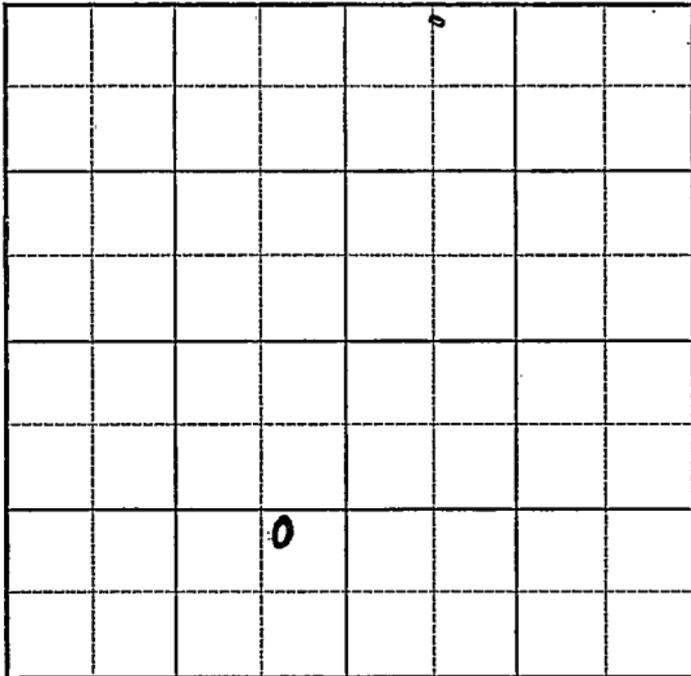

SOUTH

Map No. 45 Sec. 28 Twp. 17 R. 8W

Well No. 2 Kuhnle

Continental etal Company

FIRST REPORT Contractor

C E L SW

SECTION PLAT

_____ Ft. from N. Line

1240 Ft. from S. Line

440 Ft. from E. Line

_____ Ft. from W. Line

EDWARDS POOL

Location _____

RECORD

Rig up _____

Drilling and Remarks:

Derrick

Cased _____ in., _____ ft.

Sand _____

Gas _____

Oil _____

Total Depth _____

PRODUCTION

1st 24 hrs. Nat. _____

1st 24 hrs. after shot _____

Gas _____ Cu. Ft.

Dry Hole _____

Abandoned _____

Date

AUG 27 1941 19

S I I FWIS Scout

Map No. K-45 Sec. 28 Twp. 17 R. 8W

Well No. 2 Kuhnle

Continental etal Company

COMPLETED

Contractor

C E L S W

_____ Ft. from N. Line


1240 Ft. from S. Line

440 Ft. from E. Line

_____ Ft. from W. Line

EDWARDS POOL

SECTION PLAT

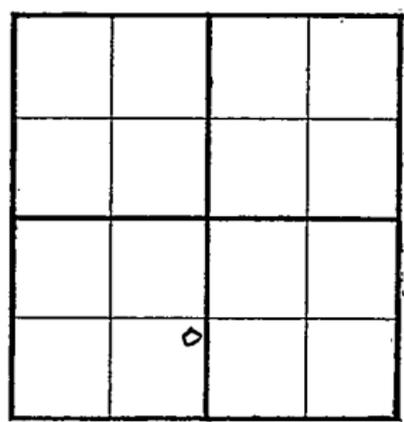

Location _____

Rig up _____

Drilling and Remarks:

Oil 3243
6" @ 3244
2000 acid
Pump 145 R.Y.

396 R.Y.

RECORD

Cased _____ in., _____ ft.

Sand _____

Gas _____

Oil _____

Total Depth 3247

PRODUCTION

1st 24 hrs. Nat. _____

1st 24 hrs. after shot _____

Gas _____ Cu. Ft.

Dry Hole _____

Abandoned _____

Date

SEP 24 1941 19

S. J. LEWIS

Scout