

KANSAS


Ellsworth

Form 51-5M-7-40-Palace

Section 28 Township 17 Range 8-W

Well No. 8 Rolfs

Company Continental et al

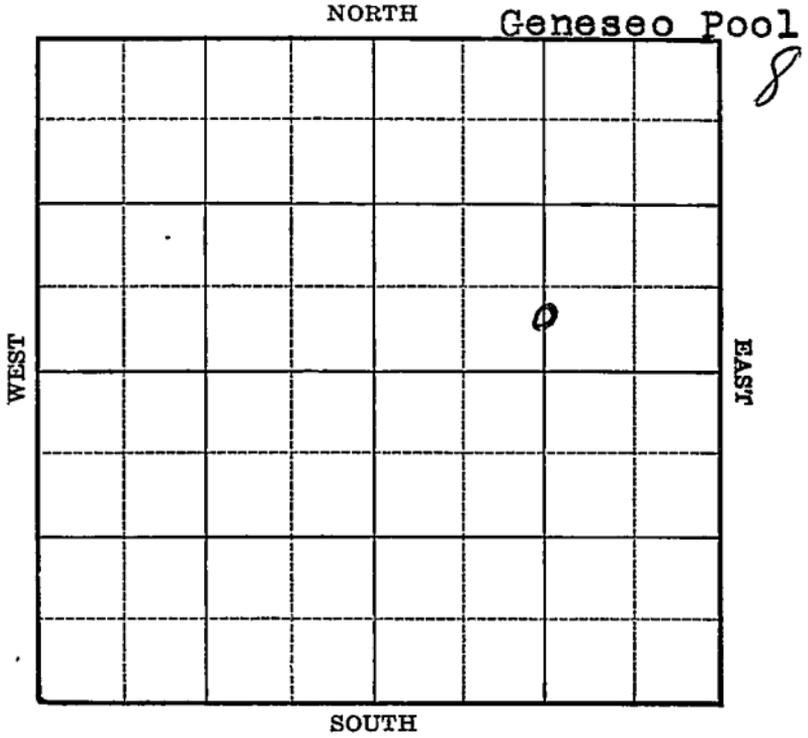

Map No. 46 Sec. 28 Twp. 17 R. 8W

Well No. 8 Rolfs

Continental etal Company

FIRST REPORT Contractor

SECTION PLAT

C S L N E


 Ft. from N. Line

440 Ft. from S. Line

1320 Ft. from E. Line

 Ft. from W. Line

GENESEO POOL

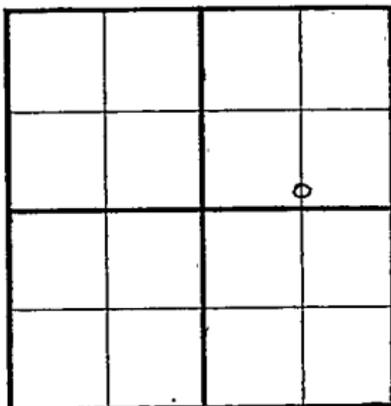

Location

Rig up

Drilling and Remarks:

10" - 208

W O C

RECORD

Cased in., ft.

Sand

Gas

Oil

Total Depth

PRODUCTION

1st 24 hrs. - Nat.

1st 24 hrs. after shot

Gas Cu. Ft.

Dry Hole

Abandoned

Date

FEB 19 1941₁₉

S. J. LEWIS

Scout

