

KANSAS

FORM 51 5M 10-41 PETROL


Ellsworth

Section 28 Township 17 Range 8-W

Well No. #1 Kunkle "B"

Company Continental et al

NORTH Geneseo Pool

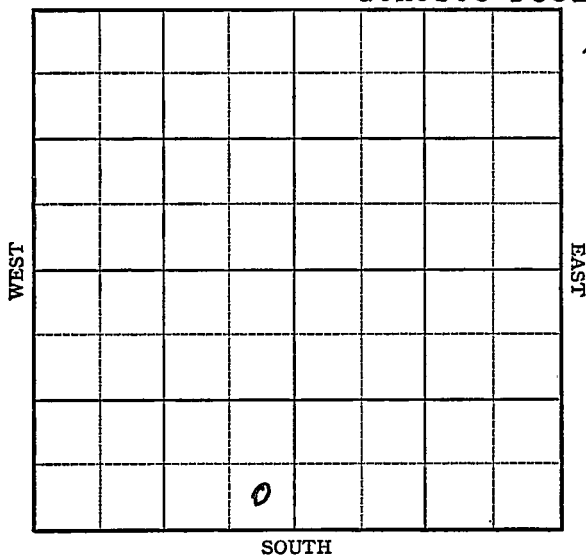

KANSAS

Ellsworth

Sec. 28 Twp. 17 R. 8-W

Well No. #1 Kunkle "B" Farm

Continental et al Company
(Geneseo)


Ft. from N. Line

330 Ft. from S. Line

330 Ft. from E. Line

Ft. from W. Line

Elev. 1778

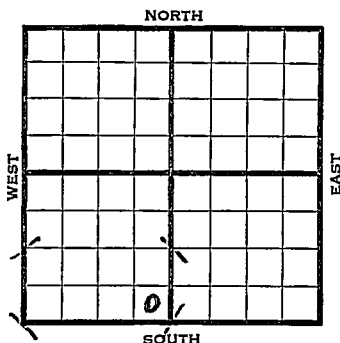


1942	REPORT
5/13	Rotary.
5/20	10" - 203' Drlg. 2175'
5/27	Arb. 3229' T.D. 3233' 6" - 3230'
	RUST.
6/3	T.D. 3239' 500 acid. 3000' oil.
6/10	" " " "
6/17	" " " "
6/24	Arb. 3229'
	6" - 3230'
	T.D. 3239'
	2500 acid.
	Echometer potential 1843 bbls.
	40.6 Gravity
	COMPLETED

Ellsworth

Map No. 75 Sec. 28 Twp. 17 R. 8WWell No. 1 Kunkle "B"Continental etal. Company**FIRST REPORT**

Contractor

SE S W

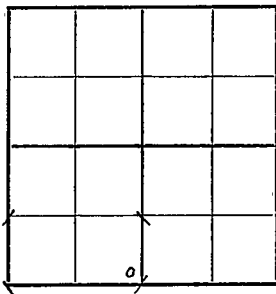SECTION PLAT Ft. from N. Line330 Ft. from S. Line330 Ft. from E. Line Ft. from W. Line**GENESEO POOL****RECORD**Location Cased in., ft.Rig up Sand

Drilling and Remarks:

Gas Oil Total Depth

Rotary

PRODUCTION1st 24 hrs. Nat. 1st 24 hrs. after shot Gas Cu. Ft.Dry Hole Abandoned

Date

MAY 13 194219S. J. LEWIS - Scout

Ellsworth KANSAS

Map No. 45 Sec. 28 Twp. 17 R. 8WWell No. 1 Kunkle "B"Continental et al. CompanyCOMPLETED Contractor

SE SW

SECTION PLAT

 Ft. from N. Line330 Ft. from S. Line330 Ft. from E. Line Ft. from W. Line

GENESEO POOL

Location Rig up

Drilling and Remarks:

Cr 832296 4 @ 32302500 acidEcho R 4. 1843406 Gr

RECORD

Cased in., ft.Sand Gas Oil Total Depth 3239

PRODUCTION

1st 24 hrs. Nat. 1st 24 hrs. after shot Gas Cu. Ft.Dry Hole Abandoned

Date

JUN 24 194219S. J. LEWISScout