


Section 28 Township 17 Range 8-W

Well No. 2 Rolfs

Company Continental et al

NORTH Edwards Pool 7

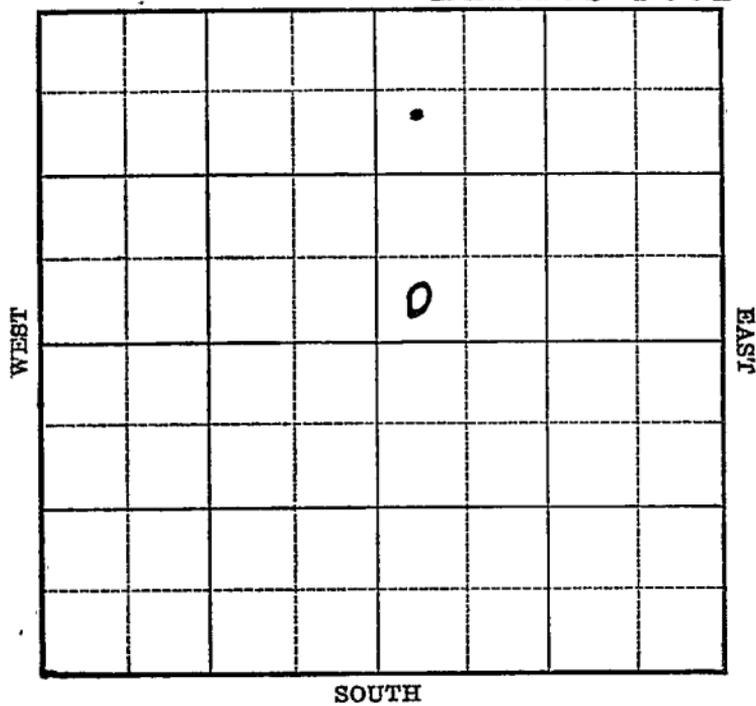

Sec. 28 Twp. 17 R. 8-W

Well No. #2 Rolfs Farm

Continental et al Company


(Edwards)

\_\_\_\_\_ Ft. from N. Line

440 Ft. from S. Line

\_\_\_\_\_ Ft. from E. Line

440 Ft. from W. Line

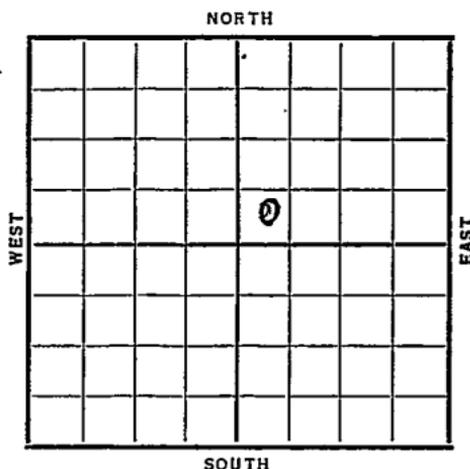

Elev. 1781'

Date	REPORT
1939	
2/8	B.R.R.
2/17	R.U.R.
2/23	10" - 210' Drlg. 1750'!
3/3	Arb. 3206-12' T.D.
	7" - 3207' RUST.
3/10	" " "
3/17	T. D. 3239' 200' oil.
	1000 acid. Swabbed down.
	No fill-up. Will deepen.
3/24	T. D. 3244'
	Shot 5 qts. 3224-30' 300' oil.
	Shot 10 qts. 3230-40' 500 acid.
	No help. Reacidizing.
	<b>OVER</b>

1939  
3/29

7" - 3207'

Arb. 3206'

T. D. 3244'

4500 acid (Total)

Shot 15 qts. "

Pump 125 bbls. 8 hrs.

Potential 375 bbls.

COMPLETED

Map No. 45 Sec. 28 Twp. 17 R. 8WWell No. 2 RolfsContinental etal Company

Contractor

**FIRST REPORT**

SW NE

\_\_\_\_\_ Ft. from N. Line

440 Ft. from S. Line

\_\_\_\_\_ Ft. from E. Line

440 Ft. from W. Line**SECTION PLAT**

		0	

**EDWARDS POOL**

Location \_\_\_\_\_

Rig up \_\_\_\_\_

Drilling and Remarks:

ERR

**RECORD**

Cased \_\_\_\_\_ in., \_\_\_\_\_ ft.

Sand \_\_\_\_\_

Gas \_\_\_\_\_

Oil \_\_\_\_\_

Total Depth \_\_\_\_\_

**PRODUCTION**

1st 24 hrs. Nat. \_\_\_\_\_

1st 24 hrs. after shot \_\_\_\_\_

Gas \_\_\_\_\_ Cu. Ft.

Dry Hole \_\_\_\_\_

Abandoned \_\_\_\_\_

Date

FEB 8 - 1939

H. D. Hatfield Scout

Misc. Small Maps	<i>RMH</i>
Cards	<i>RMH</i>
Tracing	<i>RMH</i>
France Map	<i>RMH</i>
Scarborough Map	<i>RMH</i>
Moody Map	<i>RMH</i>
Geological Dept.	<i>RMH</i>
Moody Flat Book	<i>RMH</i>

Ellsworth

Map No. 45 Sec. 28 Twp. 17 R. 8W

Well No. 2 Rof's

Continental etal

Company

Contractor

**COMPLETED**

SW NE

\_\_\_\_\_ Ft. from N. Line

440 Ft. from S. Line

\_\_\_\_\_ Ft. from E. Line

440 Ft. from W. Line

**EDWARDS POOL**

**SECTION PLAT**

		0	

Location \_\_\_\_\_

Rig up \_\_\_\_\_

Drilling and Remarks:

*4500 Acid (Total)  
shot 15 gts ✓*

*P-12 5/8*

*Pot 375*

**RECORD**

Cased 7 in. 3207 ft.

Sand 4th 3206

Gas \_\_\_\_\_

Oil \_\_\_\_\_

Total Depth 3244

**PRODUCTION**

1st 24 hrs. Nat. \_\_\_\_\_

1st 24 hrs. after shot \_\_\_\_\_

Gas \_\_\_\_\_ Cu. Ft.

Dry Hole \_\_\_\_\_

Abandoned \_\_\_\_\_

Date

MAR 29 1939 19

H. D. Hatfield Scout

Misc Small Maps	<i>Ray</i>
Cards	<i>Ray</i>
Tracing	<i>Ray</i>
France Map	<i>Ray</i>
Scarborough Map	<i>Ray</i>
Moody Map	
Geological Dept.	<input checked="" type="checkbox"/>
Moody Flat Book	