

Sec. 28 Twp. 17 R. 8-W

Well No. #3 Rotifs Farm _____

Continental Company _____


(Edwards)

330 Ft. from N. Line

_____ Ft. from S. Line

_____ Ft. from E. Line

330 Ft. from W. Line

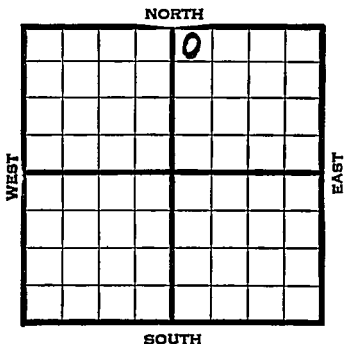

Elev. 1790

1939	REPORT
7/5	Rotary.
7/13	10" - 206' Drlg. 1850'
7/20	Arb. 3211' 7" - 3212'
	T.D. 3213' RUST.
7/27	T.D. 3247', 1/2 bbls. oil per
	hours.
8/2	Arb. 3211'
	7" - 3212'
	T.D. 3247'
	X 4000 acid.
	Potential 1806 bbls., pump.
	COMPLETED

Map No. 45 Sec. 28 Twp. 17 R. 8WWell No. 3 RolfsContinental

Company

Contractor

FIRST REPORT

NW NE

SECTION PLAT

		0	

330 Ft. from N. Line

_____ Ft. from S. Line

_____ Ft. from E. Line

330 Ft. from W. Line

EDWARDS POOL

Location _____

Rig up _____

Drilling and Remarks:

Rotary

RECORD

Cased _____ in., _____ ft.

Sand _____

Gas _____

Oil _____

Total Depth _____

PRODUCTION

1st 24 hrs. Nat. _____

1st 24 hrs. after shot _____

Gas _____ Cu. Ft.

Dry Hole _____

Abandoned _____

Date
JUL 5 1939.

19

S. J. LEWIS

Scout

Misc. Small Maps

Cards

Tracing

France Map

Scarborough Map

Moody Map

Geological Dept.

Moody Flat Book

RAY
Paul
Joe
Ray

Map No. 45 Sec. 28 Twp. 17 R. 8WWell No. 3 RolfsContinental

Company

Contractor

COMPLETED

NW NE

330 Ft. from N. Line

_____ Ft. from S. Line

_____ Ft. from E. Line

330 Ft. from W. Line**SECTION PLAT**

		o	

EDWARDS POOL

Location _____

Rig up _____

Drilling and Remarks:

*Ar 8 3211**7" @ 3212**4000 acid**Pump. 1806 ft.***RECORD**

Cased _____ in., _____ ft.

Sand _____

Gas _____

Oil _____

Total Depth 3247**PRODUCTION**

1st 24 hrs. Nat. _____

1st 24 hrs. after shot _____

Gas _____ Cu. Ft.

Dry Hole _____

Abandoned _____

Date

AUG 2 1939 19S. J. LEWIS Scout

Misc Small Maps *RM*
Cards *RM*
Tracing *RM*
France Map *RM*
Scarborough Map *RM*
Moody Map
Geological Dept.
Moody Flat Book