

KANSAS


Ellsworth

Form 51-5M-7-40-Palace

Section 28 Township 17 Range 8-W

Well No. 6 Rolfs

Company Continental et al

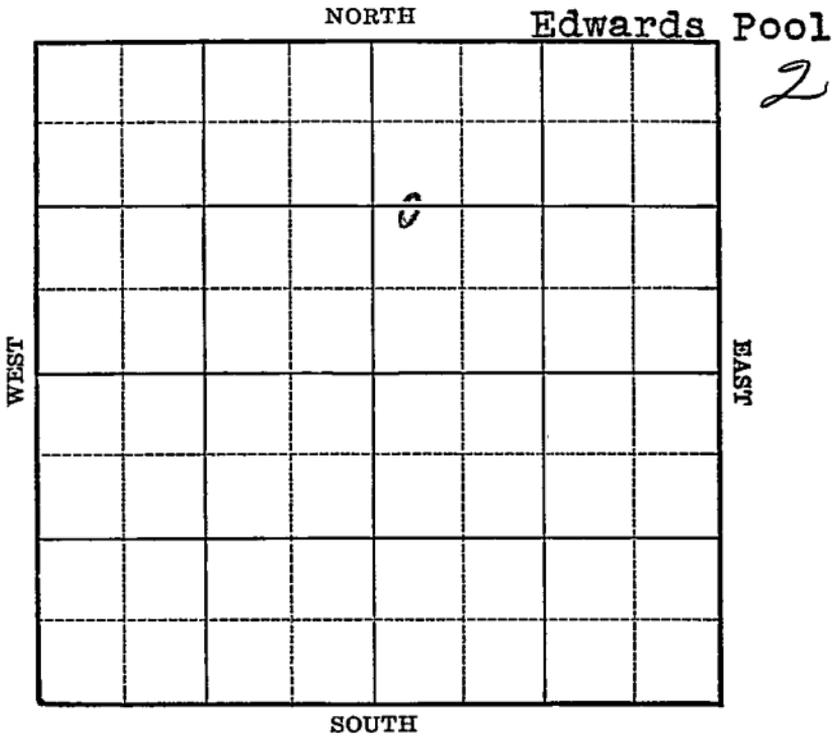

Map No. 45 Sec. 28 Twp. 17 R. 8WWell No. 6 RolfsContinental etal CompanyFIRST REPORT Contractor

C W L NE

SECTION PLAT

1320 Ft. from N. Line

_____ Ft. from S. Line

_____ Ft. from E. Line

440 Ft. from W. Line

EDWARDS POOL

Location _____

Rig up _____

Drilling and Remarks:

10" - 214

WOC

RECORD

Cased _____ in., _____ ft.

Sand _____

Gas _____

Oil _____

Total Depth _____

PRODUCTION

1st 24 hrs. Nat. _____

1st 24 hrs. after shot _____

Gas _____ Cu. Ft.

Dry Hole _____

Abandoned _____

Date

JAN 8 1941 19

S. J. LEWIS Scout

Map No. 45 Sec. 28 Twp. 17 R. 8W

Well No. 6 Rolfs

Continental etal Company

~~COMPLETED~~ Contractor

SECTION PLAT

C W L N E

1320 Ft. from N. Line

_____ Ft. from S. Line

_____ Ft. from E. Line

440 Ft. from W. Line

EDWARDS POOL

Location _____

Rig up _____

Drilling and Remarks:

Ar 8 3207

6" @ 3208

2000 Acid

Pump. 509 Pk.

39.6 Gr.

RECORD

Cased _____ in., _____ ft.

Sand _____

Gas _____

Oil _____

Total Depth 3234

PRODUCTION

1st 24 hrs. Nat. _____

1st 24 hrs. after shot _____

Gas _____ Cu. Ft.

Dry Hole _____

Abandoned _____

Date

JAN 29 1941 19

S. I. LEWIS Scout