

KANSAS

Form 51—5M—7-40—Palace

Ellsworth

Section 28 Township 17 Range 8-W

Well No. 7 Rolfs

Company Continental et al


Geneseo Pool

NORTH

WEST

EAST

SOUTH

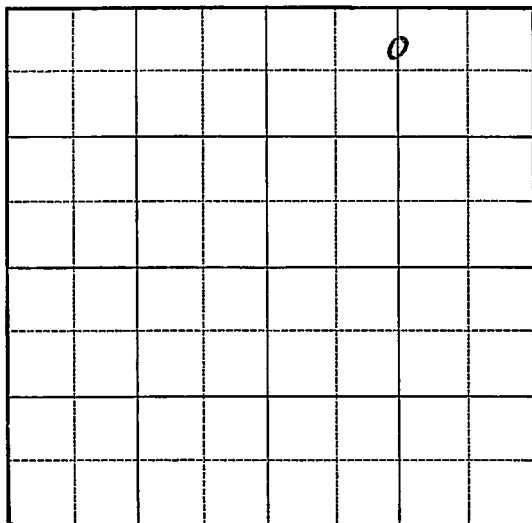


[illegible]

Map No. 45 Sec. 28 Twp. 17 R. 8WWell No. 7 RolfsContinental etal CompanyFIRST REPORT Contractor

C N L N E .

440 Ft. from N. Line Ft. from S. Line1320 Ft. from E. Line Ft. from W. Line

SECTION PLAT

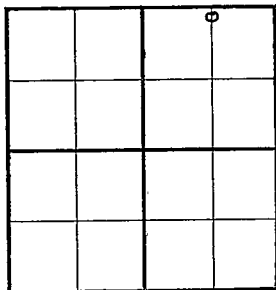

GENESEO POOL

Location Rig up Drilling and Remarks:

Derrick

RECORD

Cased in., ft.Sand Gas Oil Total Depth

PRODUCTION

1st 24 hrs. Nat. 1st 24 hrs. after shot Gas Cu. Ft.Dry Hole Abandoned

Date

JAN 29 1941₁₉S. J LEWIS Scout

Map No. 45 Sec. 28 Twp. 17 R. 8WWell No. 7 Rofs

Continental etal Company

COMPLETED Contractor

C N L NE


440 Ft. from N. Line

Ft. from S. Line

1320 Ft. from E. Line

Ft. from W. Line

SECTION PLAT

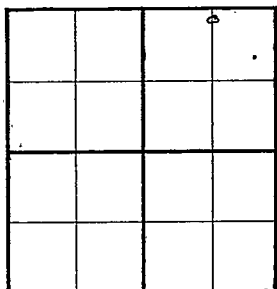

GENESEO POOL

Location

Rig up

Drilling and Remarks:

*Aug 3211**6" 3212**4000 acid**Pump 305 R.Y.**40' Gr.*

RECORD

Cased _____ in., _____ ft.

Sand _____

Gas _____

Oil _____

Total Depth 3242

PRODUCTION

1st 24 hrs. Nat. _____

1st 24 hrs. after shot _____

Gas _____ Cu. Ft.

Dry Hole _____

Abandoned _____

Date

FEB 26 1941 19S. J. LEWIS Scout