

KANSAS

Form 51-5M-7-40-Palace


Ellsworth

Section 28 Township 17 Range 8-W

Well No. #9 Rolfs

Company Continental et al

NORTH ^Geneseo Pool /

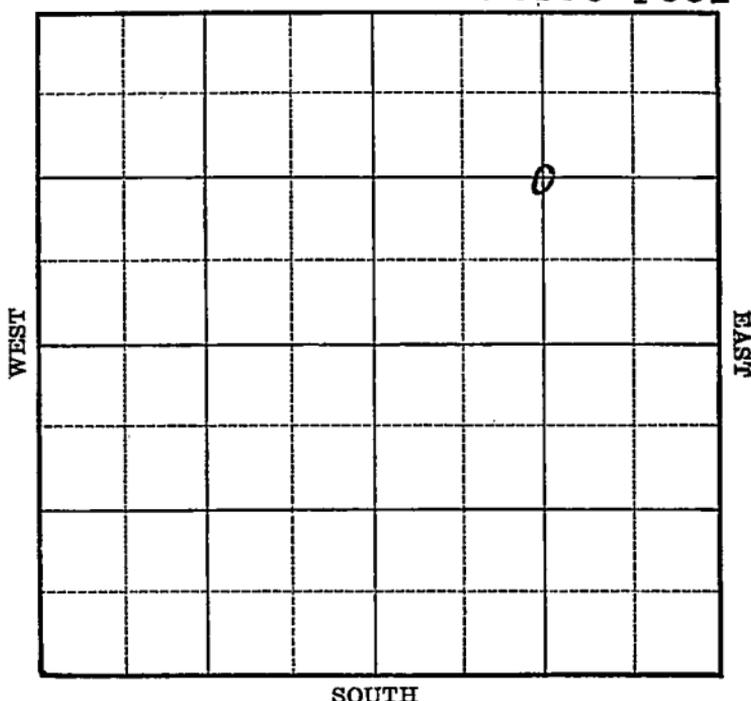

SOUTH

Sec. 28 Twp. 17 R. 8-W

Well No. #9 Rolfs Farm

Continental et al Company


(Geneseo)

_____ Ft. from N. Line

1315 Ft. from S. Line

_____ Ft. from E. Line

1315 Ft. from W. Line

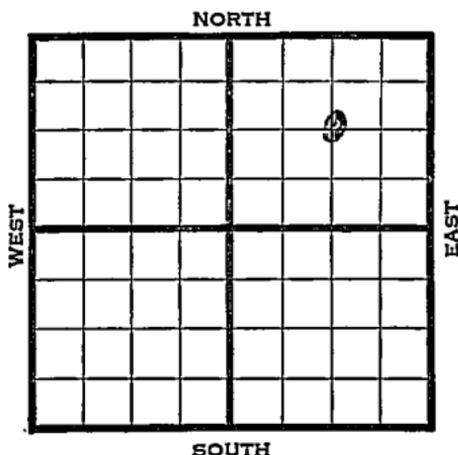

Elev. 1779

1941	REPORT
3/26	Derrick.
4/2	10" - 210' Drlg. 2740'
4/10	Arb. 3200' 6" - 3201'
	Drlg. 3226' 100.0' oil.
4/16	Arb. 3200'
	T.D. 3229'
	3000 acia.
	Pump 395 bbls.
	40.1 Gravity
	COMPLETED

Map No. 45 Sec. 28 Twp. 17 R. 8W

Well No. 9 Rolf's

Continental etal Company

FIRST REPORT Contractor

SECTION PLAT


C NE

 Ft. from N. Line

1315 Ft. from S. Line

 Ft. from E. Line

1315 Ft. from W. Line

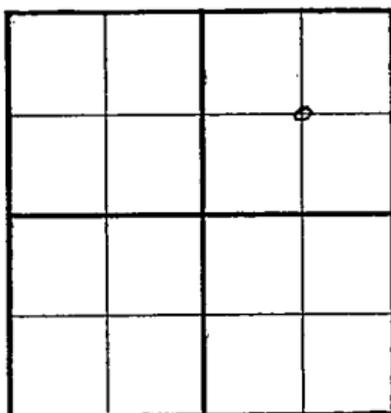

GENESEO POOL

Location

Rig up

Drilling and Remarks:

Derrick

RECORD

Cased in., ft.

Sand

Gas

Oil

Total Depth

PRODUCTION

1st 24 hrs. Nat.

1st 24 hrs. after shot

Gas Cu. Ft.

Dry Hole

Abandoned

Date

MAR 26 1941 19

S. J. LEWIS Scout

Map No. 45 Sec. 28 Twp. 17 R. 8W

Well No. 9 Rolfs

Continental etal Company

Contractor

COMPLETED

C NE

_____ Ft. from N. Line

1315 Ft. from S. Line

_____ Ft. from E. Line

1315 Ft. from W. Line

SECTION PLAT

GENESEO POOL

Location _____

Rig up _____

Drilling and Remarks:

3000 acid

*Pump 395
Hls*

40.1 Grav.

RECORD

Cased _____ in. _____ ft.

Sand *Subsided 3200*

Gas _____

Oil _____

Total Depth *3229*

PRODUCTION

1st 24 hrs. Nat. _____

1st 24 hrs. after shot _____

Gas _____ Cu. Ft.

Dry Hole _____

Abandoned _____

Date

APR 16 1941

S. J. LEWIS Scout