


Section 28 Township 17 Range 8W

Well No. #1 Zadesky

Company Dozier Oil

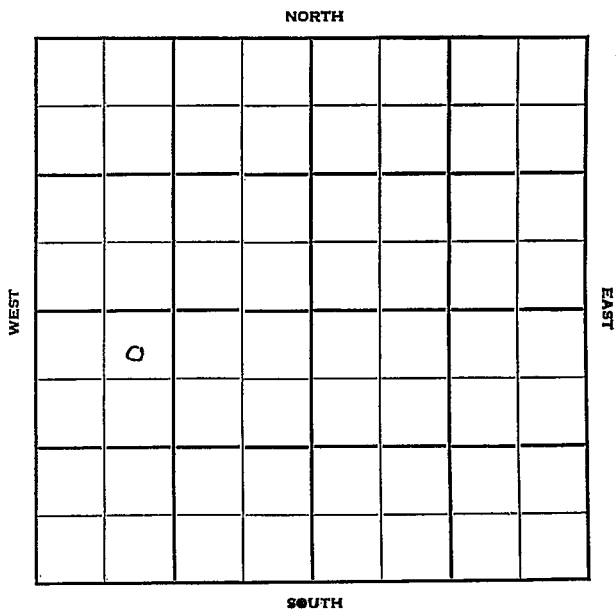

Ellsworth

Sec. 28 Twp. 17 R. 8W

Well No. #1 Zadesky Farm

Dozier Oil Company

Stagg - Contr. Contractor

Edwards


330' Ft. from N. Line

Ft. from S. Line

Ft. from E. Line

990' Ft. from W. Line

NE NW SW

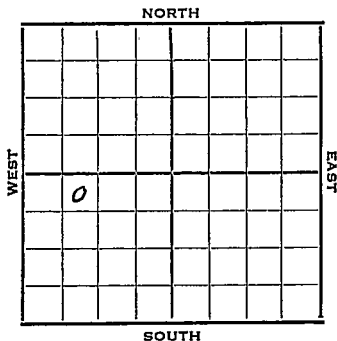

1951 Elev. 1786' REPORT

12/19 Location

1952
1/16

Spud 12-28-51
D&A TD 3291
8" @ 202'
Heeb. 2740 Br Li 2861
KC 2884 Cong. 3236
Kh. 3273 TD 3291
D&A

ABANDONED

