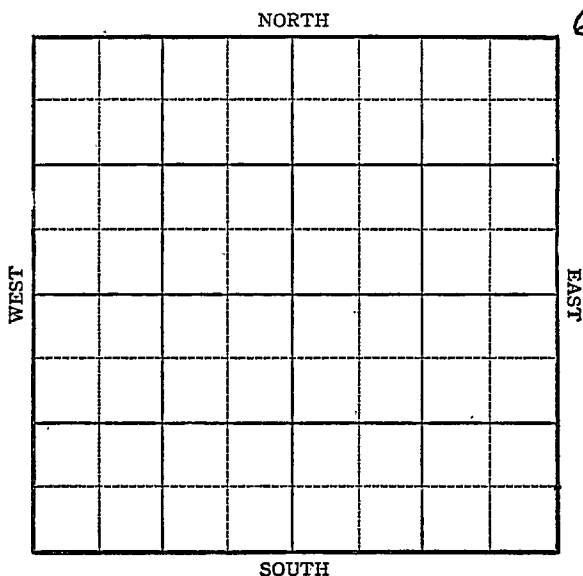


KANSAS

McPherson County

Section 28 Township 17 Range 1WWell No. #1 BlaineCompany Phillips

KANSAS

McPherson

Sec. 28 Twp. 17 R. 1W

Well No. #1 Blaine Farm


Phillips Company
Crowther

 Ft. from N. Line

330 Ft. from S. Line

660 Ft. from E. Line

 Ft. from W. Line

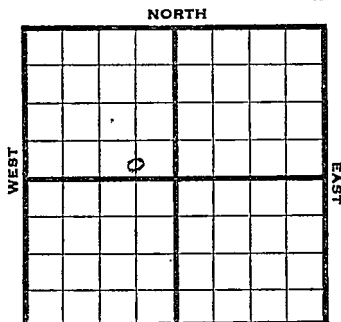

C S L SE NW 20 133 SOUTH

1945


R E P O R T

1/17 Location
1/26 8" @ 240. WOC
1/31 Drlg. 2011'
2/7 Drlg 2651
2/14 Drlg 2652
2/21 Miss 2648 S O & W
TD 2674 PB
2/28 " " "
3/7 Miss 2648
TD 2674

ABANDONED

Pool Name Crowther**KANSAS**Map No. _____ Sec. 23 Twp. 17 R. 1WWell No. 1 BlainePhillips Company**FIRST REPORT**

Contractor

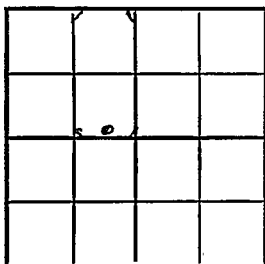C S L SE NW**SECTION PLAT**

_____ Ft. from N. Line

330 Ft. from S. Line660 Ft. from E. Line

_____ Ft. from W. Line

McPherson**RECORD**Location X

Cased _____ in., _____ ft.

Rig up _____

Sand _____

Drilling and Remarks:

Gas _____

Oil _____

Total Depth _____

PRODUCTION

1st 24 hrs. Nat. _____

1st 24 hrs. after shot _____

Gas _____ Cu. Ft.

Dry Hole _____

Abandoned _____


Date

JAN 17 1945 19 . S. J. LEWIS Scout

Pool Name CrowtherMap No. 42 Sec. 28 Twp. 17 R. 1WWell No. 1 BlainePhillips CompanyABANDONED Contractor

C S L SE NW

SECTION PLAT

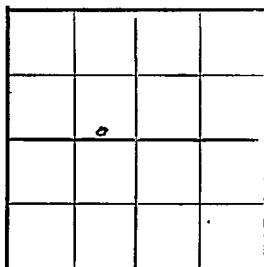 Ft. from N. Line330 Ft. from S. Line660 Ft. from E. Line Ft. from W. LineMcPhersonLocation Rig up

Drilling and Remarks:

Wells 2648

RECORD

Cased in., ft.Sand Gas Oil Total Depth 2674

PRODUCTION

1st 24 hrs. Nat. 1st 24 hrs. after shot Gas Cu. Ft.Dry Hole Abandoned

Date

MAR 7 1945 19S. J. LEWIS Scout