

KANSAS

Section 28 Township 17 Range 1WWell No. #1 BlaineCompany N.C.R.A.

NORTH

2

				0			

WEST

EAST

SOUTH

McPherson KANSAS

SEC.	TWP.	R.
28	17	1W ✓

WELL NO.

#1 Blaine

FARM

COMPANY

N C R A

CONTRACTOR

Musgrove

Henne Pool


330 Ft. from N. Line

Ft. from S. Line

Ft. from E. Line

330 Ft. from W. Line

NW NW NE

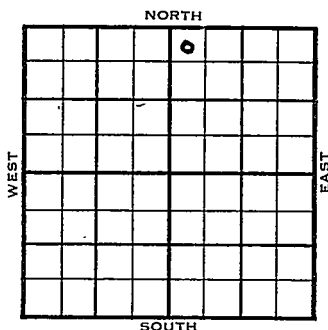

1954

ELEVATION

1343'

REPORT

3/17

Spud 3-11-54
8" @ 163' WORT~~XXXX~~

3/24

WORT

3/31

Heeb 1876 Doug 1917

Drlg. 2150'

4/7

Spud 3-11-54

D&A

TD 2710'

8" @ 163'

Heeb 1876', Doug 1917', Lans 2107',

Miss 2672'

DST 2673-75', opn 2 hrs., rec. 20'

ocm, 410#

DST 2675-85', opn 2 hrs., rec. 50'

ocm, 335#

TD 2710'

~~XXXX~~ D&A

ABANDONED

County McPherson State KansasSec. 28 (Blk.) 17 (Sur.) 1W Map No.Operator N C R AWell No. 1 Farm BlaineElev. Location NW NW NE

330 Ft. From N Line NE330 Ft. From W Line Quarter1st. Report MAR 17 1954

Completion


Remarks

Musgrove - Contr.Spudding Date 3-11-54Drlg. Data Henne Pool8" @ 163 WORT.

J. G. McGEHEE



County McPherson State Kansas
Sec. 28 (Blk.) 17 (Sur.) 1W Map No. _____
Operator N C R A
Well No. 1 Farm Blaine
Elev. 1343 Location NWNW NE

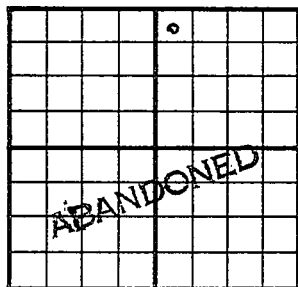

330 Ft. From N Line NE
330 Ft. From W Line Quarter
1st. Report _____
Completion APR 7 1954
Remarks Henne Pool
Musgrove - Contr.
Spudding Date 3-11-54

Drlg. Data D & A TD 2710
8" @ 163 Heeb. 1876 Doug. 1917
Lens. 2107 Miss. 2672 DST 2673-75
open 2 hr. Rec. 20' ocm 410#
DST 2675-85 open 2 hr. Rec. 50' ocm
335# TD 2710

D & A