


KANSAS

Section 28 Township 17 Range 1 W

Well No. 1 Blaine "B"

Company Mallard & Westgate-Greenland

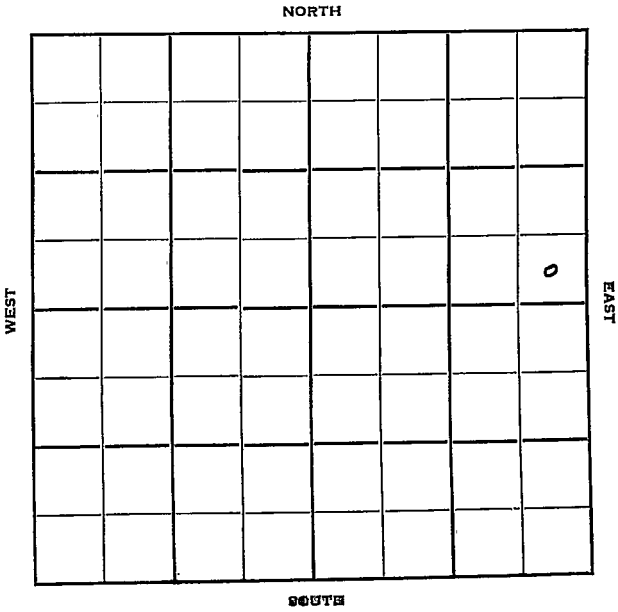

Sec. 28 Twp. 17 R. 1W

Well No. #1 Blaine "B" Farm

Mallard & Westgate-Greenland Company

Mallard D lg. Contractor


_____ Ft. from N. Line

330' Ft. from S. Line

330' Ft. from E. Line

_____ Ft. from W. Line

SE SE NE

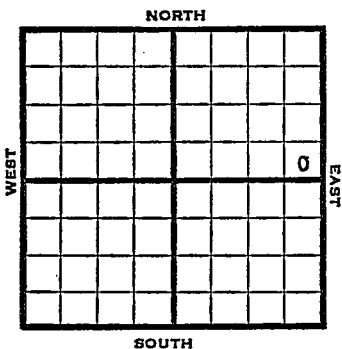

1950

Elev 1355

REPORT

5/3 Location

5/17 TD 2682
8 5/8" @ 148
Miss 2670
82 TD
D&A

ABANDONED

Kansas

Map No. _____ Sec. 28 Twp. 17 R. 1W

Well No. 1 Blaine "B"

Mallard & Westgate-Greenland Company

Mallard Drlg. Contractor

SE SE NE

_____ Ft. from N. Line

330 Ft. from S. Line

330 Ft. from E. Line

_____ Ft. from W. Line

McPherson County

SECTION PLAT

			o

Location X

Rig up

Drilling and Remarks:

RECORD

Cased _____ in., _____ ft.

Sand _____

Gas _____

Oil _____

Total Depth _____

PRODUCTION

1st 24 hrs. Nat. _____

1st 24 hrs. after shot _____

Gas _____ Cu. Ft.

Dry Hole _____

Abandoned _____

Date

MAY 3 1950 19

J. E. TYRA Scout

Map No. _____ Sec. 28 Twp. 17 R. 1W

Well No. 1 Blaine "B"

~~Mallard & Westgate Greenland~~ Company

Contractor

SE SW NE

E1. 1355
SECTION PLAT

_____ Ft. from N. Line

330 Ft. from S. Line

330 Ft. from E. Line

_____ Ft. from W. Line

ABANDONED			
			o

McPherson

Location _____

Rig up _____

Drilling and Remarks:

*8 5/8" @ 148
miss 2670-
82 T-D
DJA*

RECORD

Cased _____ in., _____ ft.

Sand _____

Gas _____

Oil _____

Total Depth 2682

PRODUCTION

1st 24 hrs. Nat. _____

1st 24 hrs. after shot _____

Gas _____ Cu. Ft.

Dry Hole _____

Abandoned _____

Date

MAY 17 1950

19

J. E. TYRA

Scout