


McPherson

KANSAS
FORM 51 IOM 12-46 PETROL

Section 28 Township 17 Range 1-W

Well No. #1 Holcomp

Company Phillips
Crowther

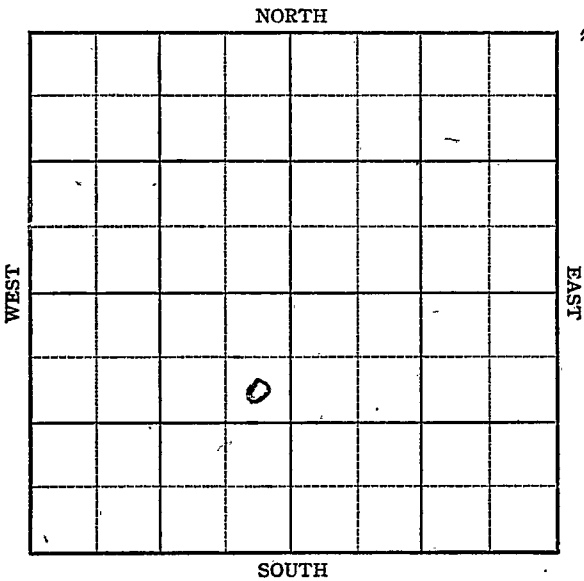



Sec. 28 Twp. 17 R. 1-W

Well No. #1 Holcomb Farm
Phillips
Growther _____ Company


990 Ft. from N. Line

_____ Ft. from S. Line

330 Ft. from E. Line

_____ Ft. from W. Line

SE NE SW

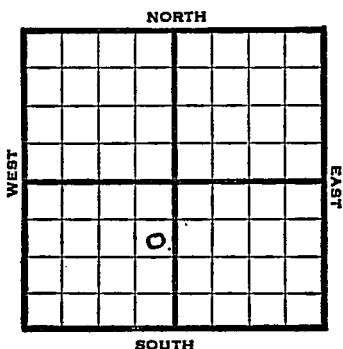

1947 Elev. 1339' REPORT

6/11 Location

6/17 10" @ 264
Drlg 1765'

6/24 Mississippi 2666'
Drlg 2695'

7/2 Arb. 3296'
TD 3330'

ABANDONED

Map No. _____ Sec. 28 Twp. 17 R. 1W

Well No. 1 Holcomb

Phillips Company

FIRST REPORT

Contractor

SE NE SW


SECTION PLAT

990 Ft. from N. Line

Ft. from S. Line

330 Ft. from E. Line

Ft. from W. Line

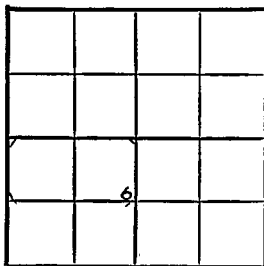

McPherson County

Location X

Rig up

Drilling and Remarks:

RECORD

Cased in, ft.

Sand

Gas

Oil

Total Depth

PRODUCTION

1st 24 hrs. Nat.

1st 24 hrs. after shot

Gas Cu. Ft.

Dry Hole

Abandoned

Date

JUN 11 1947 19 S I LEWIS Scout

Map No. 42 Sec. 28 Twp. 17 R. 1W

Well No. 1 Holcomb

Phillips Company

ABANDONED

Contractor

SE NE SW


E 11389
SECTION PLAT

990 Ft. from N. Line

 Ft. from S. Line

330 Ft. from E. Line

 Ft. from W. Line

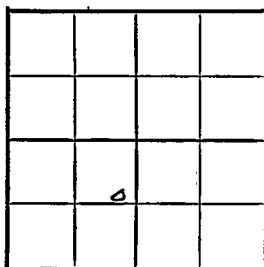

McPherson County

Location

Rig up

Drilling and Remarks:

See 83296

RECORD

Cased in., ft.

Sand

Gas

Oil

Total Depth 2280

PRODUCTION

1st 24 hrs. Nat.

1st 24 hrs. after shot

Gas Cu. Ft.

Dry Hole

Abandoned

Date

JUL 2 1947

19

S. J. LEWIS Scout