

Map No. **KANSAS** Sec. 28 Twp. 17 R. 1^w

Well No. 1- Lilly Farm
W. L. Sidwell et al Company


330 Ft. from N. Line

_____ Ft. from S. Line

_____ Ft. from E. Line

990 Ft. from W. Line

1932

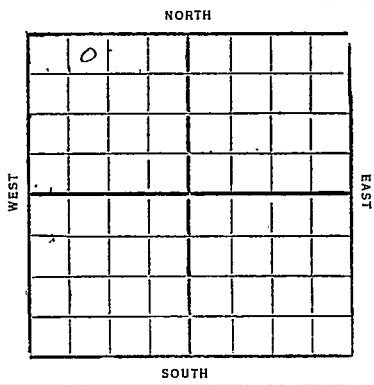

Date	REPORT
5/11	Doc
5/18	—
5/25	Doc
6/1	Doc
6/8	Big & tools
6/15	Run up
6/22	Spdg 170'
6/29	" 300'
7/6	Spd 580' for 15"
7/13	—
7/20	—
7/27	—
8/3	—
8/10	15"-580 Dreg 1205'
8/17	Spd 1205'
8/24	— 10/5 — 11/16 —
8/31	— 10/12 — 11/23 —
9/7	— 10/19 — 11/30 —
9/14	— 10/26 — 12/7 —
9/21	— 11/2 — 12/14 —
9/30	— 11/9 — 12/21 —

12/28- SD. 1205'

1933

1/4 —

1/11 —

1/18 —

1/25 —

2/1 —

2/8 —

2/15 —

2/22- TD. 1205' Clg out

3/4 —

3/8-10"-1968 Wrlg 2050'

3/10-16" 2000' Wrlg 2458'

3/22 Top chat 2642 18" 2652 small show

wd 2770' + N.F.W. Wrlg 2834

3/29 Black line 2824 Top Hemton

2920 N.F.W. 6" 2961 N.F.W. 2996

Wrlg 3025

4/4 6" 3016 - Viola 3109 show oil 3115

show oil 3128-30 - N.F.W. 3130-45'

TD. 3166 W.R.-6"

4/12-6" 3109' Top Wilcox 3222'

Top siliceous 3285 TD. 3287'

No shows

Abandoned

McPherson

42 KANSAS Map No. Sec. **28** Twp. **17** R. **1** ^W

Well No. **1** *Lilly*

N. L. Dismell *Dr* *Fl* Company

Contractor

FIRST REPORTS

330 Ft. from N. Line

..... Ft. from S. Line

..... Ft. from E. Line

990 Ft. from W. Line

SECTION PLAT

0			

Location

Rig up

Drilling and Remarks:

RECORD

Cased in., ft.

Sand

Gas

Oil

Total Depth

PRODUCTION

1st 24 hrs. Nat.

1st 24 hrs. after shot

Gas Cu. Ft.

Dry Hole

Abandoned

Date

MAY 1 1 1932

CHAS. L. SHERWOOD

192

Scout

[Handwritten signature]

Returned	<i>[Signature]</i>
Cards	<i>[Signature]</i>
Tracing	<i>[Signature]</i>
France Map	<i>[Signature]</i>
Scarborough Map	<i>[Signature]</i>
Moody Map	<i>[Signature]</i>
Scarborough Plat Book	
Moody Plat Book	

McPherson

W

42 KANSAS

Map No. Sec. 28 Twp. 17 R. 1

Well No. 1 Lilly

N. E. Diowell et al Company

Contractor

COMPLETED

SECTION PLAT

330 Ft. from N. Line

Ft. from S. Line

Ft. from E. Line

990 Ft. from W. Line

0			

ABANDONED

Location

Rig up

Drilling and Remarks:

Top Niles 3222'

Top Siliceous 3285'

No Shows.

RECORD

Cased 6 in., 3109 ft.

Sand

Gas

Oil

Total Depth 3287

PRODUCTION

1st 24 hrs. Nat.

1st 24 hrs. after shot

Gas Cu. Ft.

Dry Hole ✓

Abandoned ✓

Date

APR 12 1933

192 CHAS. L. SHERWOOD Scout

[Handwritten scribbles and lines]

Returned	
Cards	<i>WMB</i>
Tracing	<i>WMB</i>
France Map	<i>+</i>
Scarborough Map	<i>+</i>
Moody Map	<i>+</i>
Scarborough Plat Book	
Moody Plat Book	