

KANSAS

FORM 51 5M 4-41 PETROL


Ellsworth

Section 29 Township 17 Range 9-W

Well No. #3 Mollhagen "B"

Company Cities Service Oil et al

NORTH Schroeder Pool

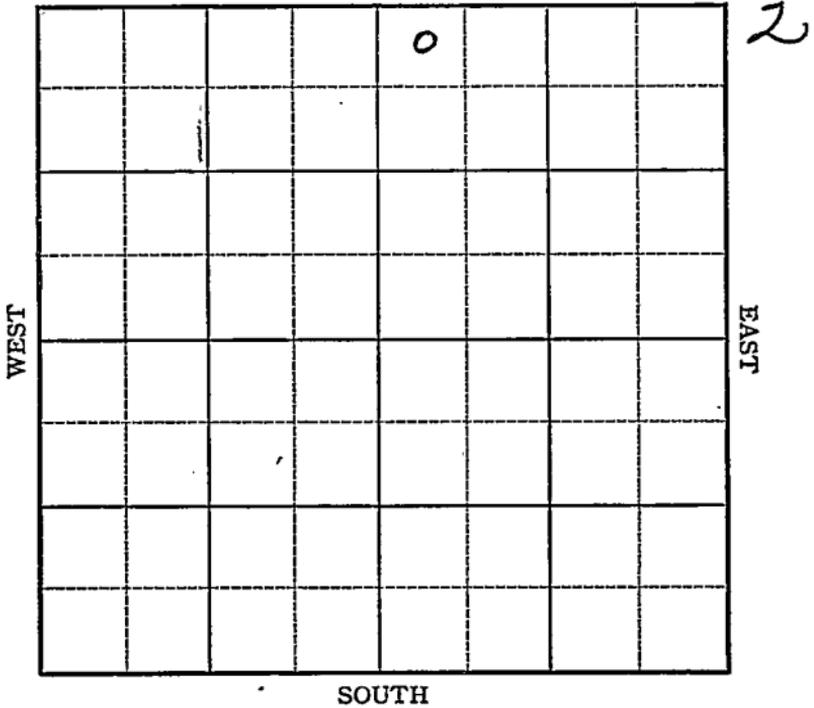

Sec. 29 Twp. 17 R. 9-W

Well No. #3 Mollhagen "B" Farm

Cities Service Oil et al Company.

(Schroeder)


440 Ft. from N. Line

_____ Ft. from S. Line

_____ Ft. from E. Line

440 Ft. from W. Line

Elev. 1776

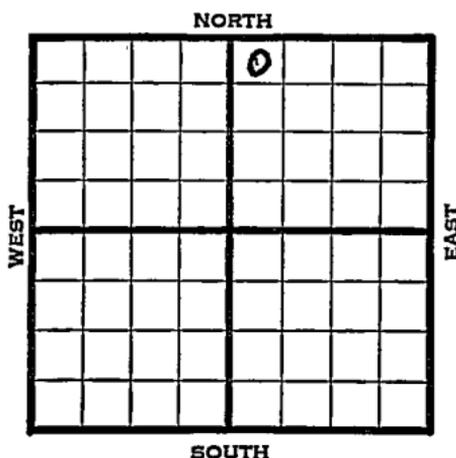

	REPORT
1941	
4/30	8" - 214'
	Drlg. 2118'
5/7	Arb. 3264'
	T.D. 3302'
	No shows.
	ABANDONED

Map No. 75 Sec. 29 Twp. 17 R. 9W

Well No. 3 Mollhagen "B"

Cities Service Oil etal Company

ABANDONED Contractor

NW NE

440 Ft. from N. Line

_____ Ft. from S. Line

_____ Ft. from E. Line

440 Ft. from W. Line

SECTION PLAT

		o	

SGHROEDER POOL

Location _____

Rig up _____

Drilling and Remarks:

Cor 83264
No show

RECORD

Cased _____ in., _____ ft.

Sand _____

Gas _____

Oil _____

Total Depth 3902

PRODUCTION

1st 24 hrs. Nat. _____

1st 24 hrs. after shot _____

Gas _____ Cu. Ft.

Dry Hole _____

Abandoned _____

Date

MAY 7 1941 19

S. J. LEWIS Scout