


Section 29 Township 17 Range 9-W

Well No. #2 Mollhagen "C"

Company Cities Service Oil et al

NORTH Schroeder Pool

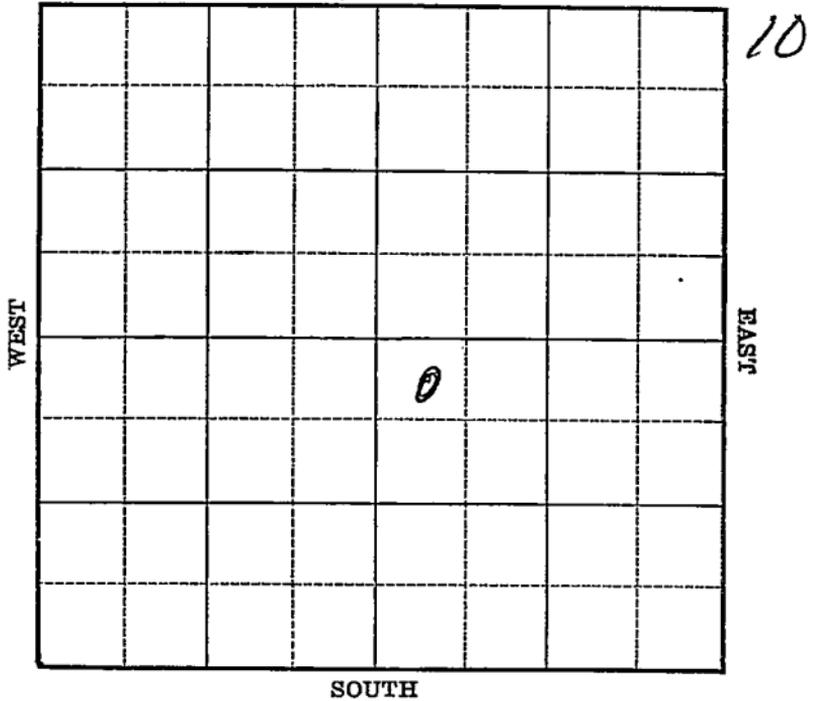

Sec. 29 Twp. 17 R. 9-W

Well No. #2 Mollhagen "C" Farm

Cities Service Oil et al Company

(Schroeder)


440 Ft. from N. Line

Ft. from S. Line

Ft. from E. Line

440 Ft. from W. Line

Elev. 1769

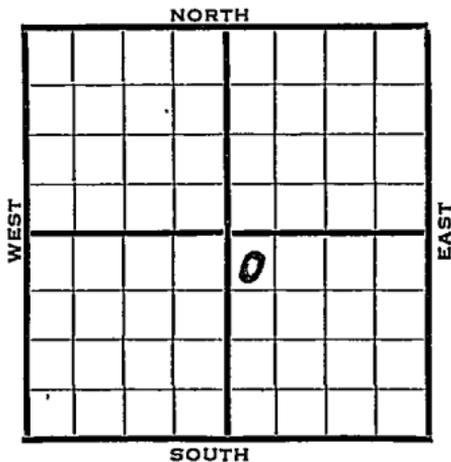

1940	REPORT
5/1	Blg. rotary Derrick.
5/9	8" - 208' WOC.
5/16	Drlg. 2135'
5/23	Arb. 3253' T.D. 3259'
	Run pipe.
5/29	" "
6/6	T.D. 3325' 5" - 3325' WOC.
6/13	" " " " "
6/19	Arb. 3253'
	5" - 3325'
	T.D. 3325'

ABANDONED

Map No. 45 Sec. 29 Twp. 17 R. 9W

Well No. 2 Mollhagen "C"

Cities Service Oil et al Company

Contractor

FIRST REPORT

SECTION PLAT

NW SE
440 Ft. from N. Line
 _____ Ft. from S. Line
 _____ Ft. from E. Line
440 Ft. from W. Line

		o	

SCHROEDER POOL

Location _____

Rig up _____

Drilling and Remarks:

**Bldg. Roty.
Derrick**

RECORD

Cased _____ in., _____ ft.

Sand _____

Gas _____

Oil _____

Total Depth _____

PRODUCTION

1st 24 hrs. Nat. _____

1st 24 hrs. after shot _____

Gas _____ Cu. Ft.

Dry Hole _____

Abandoned _____

Date

MAY 1 1940 19

S. I. LEWIS Scout

Map No. 45 Sec. 29 Twp. 17 R. 9W

Well No. 2 Mollhagen "C"

Cities Service Oil etal Company

Contractor

ABANDONED

NW SE

440 Ft. from N. Line

_____ Ft. from S. Line

_____ Ft. from E. Line

440 Ft. from W. Line

SECTION PLAT

		o	

SCHROEDER POOL

Location _____

Rig up _____

Drilling and Remarks:

CR 3253
5" C 3925

RECORD

Cased _____ in., _____ ft.

Sand _____

Gas _____

Oil _____

Total Depth 3325

PRODUCTION

1st 24 hrs. Nat. _____

1st 24 hrs. after shot _____

Gas _____ Cu. Ft.

Dry Hole _____

Abandoned _____

Date

JUN 19 1940 19. _____ S. J. LEWIS Scout