

# KANSAS


## Ellsworth

FORM 51 5M 2-38 TPCO.

Section 29 Township 17 Range 9-W

Well No. #4 Schreoder "A"

Company Cities Service Oil et al

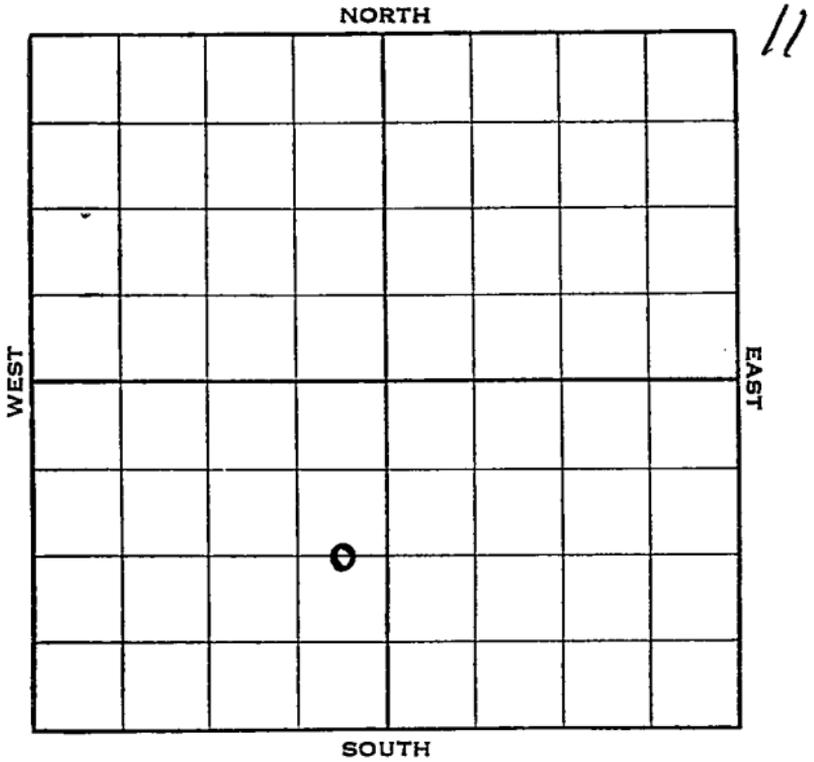

Sec. 29 Twp. 17 R. 9-W

Well No. #4 Schroeder "A" Farm


Cities-Service Oil et al Company

\_\_\_\_\_ Ft. from N. Line

1320 Ft. from S. Line

330 Ft. from E. Line

\_\_\_\_\_ Ft. from W. Line

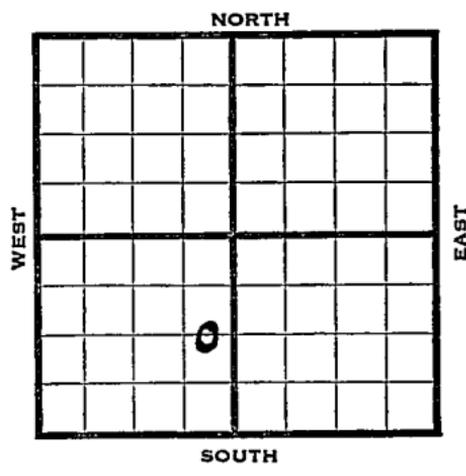

Elev. 1767

1938	REPORT
8/31	Location
9/9	10" - 245'. WOC.
9/16	Dlg. 2515'.
9/23	Arb. 3230', T.D. 3231', 6" - 3231'. RUST.
9/30	T. D. 3237' H.F.O. 6 hrs.
10/5	6" - 3231'. Arb. 3230'.
	T. D. 3237'.
	Potential 1997 bbls., Nat'l.
	<b>COMPLETED</b>

Ellsworth KANSAS

Map No. 45 Sec. 29 Twp. 17 R. 9WWell No. 4 Schroeder "A"Cities Service Oil et al Company

Contractor

## FIRST REPORT

C E L SW

       Ft. from N. Line1320 Ft. from S. Line330 Ft. from E. Line       Ft. from W. Line

## SECTION PLAT


Location XRig up       

Drilling and Remarks:

## RECORD

Cased        in.,        ft.Sand       Gas       Oil       Total Depth       

## PRODUCTION

1st 24 hrs. Nat.       1st 24 hrs. after shot       Gas        Cu. Ft.Dry Hole       Abandoned       

Date

AUG 31 1938

19

H. D. Hatfield

Scout

Map No. 45 Sec. 29 Twp. 17 R. 9W

Well No. 4 Schroeder "A"

Cities Service etal Company

Contractor

**COMPLETED**

SECTION PLAT

C E L SW


\_\_\_\_\_ Ft. from N. Line

1320 Ft. from S. Line

330 Ft. from E. Line

\_\_\_\_\_ Ft. from W. Line

Location \_\_\_\_\_

Rig up \_\_\_\_\_

Drilling and Remarks:

*POT 1997*

*NAT*

RECORD

Cased 6 in., 3231 ft.

Sand Arb 3230

Gas \_\_\_\_\_

Oil \_\_\_\_\_

Total Depth 3237

PRODUCTION

1st 24 hrs. Nat. \_\_\_\_\_

1st 24 hrs. after shot \_\_\_\_\_

Gas \_\_\_\_\_ Cu. Ft.

Dry Hole \_\_\_\_\_

Abandoned \_\_\_\_\_

Date

OCT 5 - 1938 19

H. D. Hatfield Scout