

KANSAS

Ellsworth


FORM 51 5M 4-41 PETROL

Section 29 Township 17 Range 9-W

Well No. 10 Schroeder "A"

Company Cities Service Oil et al

NORTH Schroeder pool

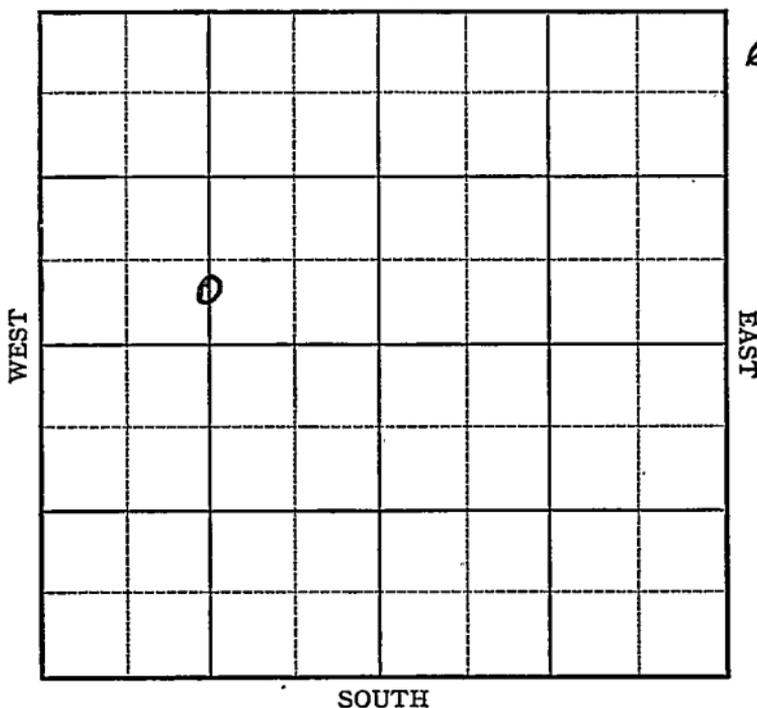

Map No. 45 Sec. 29 Twp. 17 R. 9W

Well No. 10 Schroeder "A"

Cities Service Oil etal Company

Contractor

FIRST REPORT

SECTION PLAT

C S L NW

_____ Ft. from N. Line

495 Ft. from S. Line

_____ Ft. from E. Line

1320 Ft. from W. Line

SCHROEDER POOL

Location _____

Rig up _____

Drilling and Remarks:
Derrick

RECORD

Cased _____ in., _____ ft.

Sand _____

Gas _____

Oil _____

Total Depth _____

PRODUCTION

1st 24 hrs. Nat. _____

1st 24 hrs. after shot _____

Gas _____ Cu. Ft.

Dry Hole _____

Abandoned _____

Date

MAY 27 1941

S. I. LEWIS Scout

Map No. 45 Sec. 29 Twp. 17 R. 9WWell No. 10 Schroeder "A"Cities Service Oil Company

Contractor

COMPLETED

C S L NW

 Ft. from N. Line495 Ft. from S. Line Ft. from E. Line1320 Ft. from W. Line

SECTION PLAT

SCHROEDER POOL

Location Rig up

Drilling and Remarks:

Cr 82235" @ 32242500 acidDepth 3217740' Gr

RECORD

Cased in., ft.Sand Gas Oil Total Depth 3236

PRODUCTION

1st 24 hrs. Nat. 1st 24 hrs. after shot Gas Cu. Ft.Dry Hole Abandoned

Date

JUN 18 1941 19S. I. LEWIS Scout