


Section 29 Township 17 Range 9 W

Well No. # 2 Schroeder

Company AshMar Drlg.

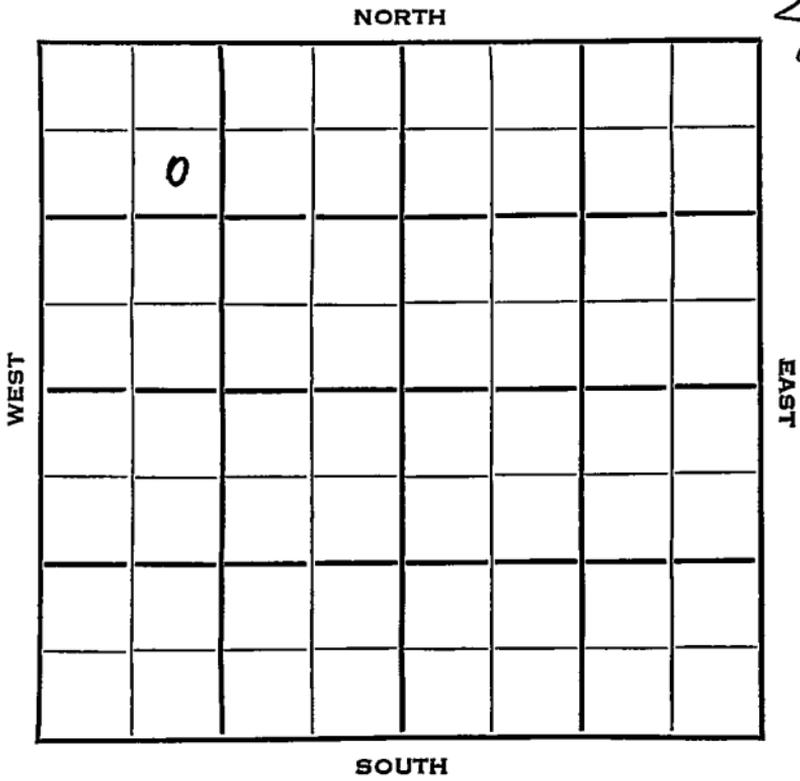



Sec. 29 Twp. 17 R. KANSAS

Well No. #2 Schroeder Farm

Ash-Mar Drlg. Company

Ash-Mar Contractor

Stoltenberg Pool


990 Ft. from N. Line

\_\_\_\_\_ Ft. from S. Line

\_\_\_\_\_ Ft. from E. Line

990 Ft. from W. Line

SE NW NW

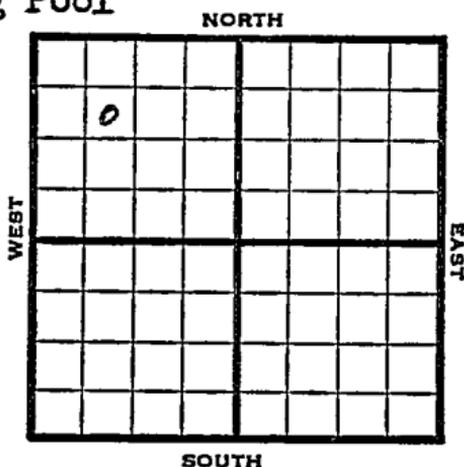

1953 Elev. 1759' REPORT

6/3 M I R

6/10 8" @ 189'  
Anhy 445'  
Drlg 2040'

6/24 Heeb 2735, Br. L. 2852, Lans 2872,  
Arb 3214  
RTD 3214

7/1 5" @ 3212'  
N.R.

7/8 CO 3214, FU 2600' oil 12 hrs.

7/15 Spud 6-5-53 Oil well TD 3214  
8" @ 189 Anhy 445 Heeb 2735  
Br lime 2852 Lans 2872 Arb 3211  
TD 3214 5" @ 3212 CO to 3214  
FU 2600' oil 12 hr.  
Comp. 35 BOPD

**COMPLETED**

County Ellsworth State Kansas

Sec. 29 (Blk. Twp.) 17 (Sur. Rge.) 9W Map No.

Operator Ash-Mar Drig.

Well No. 2 Farm Schroeder

Elev. Location SE NW 1/4

	o				
<b>FIRST REPORT</b>					

990 Ft. From N Line NW

990 Ft. From W Line Quarter

1st. Report JUN 3 1953

Completion

Remarks

Ash-Mar - Contr.

Spudding Date

Drig. Data Stoltenberg Pool

M I R

County Ellsworth State Kansas

Sec. 29 (Bk. 17) (Sur. 9W) (Twp. 17) Map No.

Operator Ash-Mar Drlg.

Well No. 2 Farm Schroeder

Elev. 1759 Location SE NW NW


990 Ft. From N Line NW

990 Ft. From W Line Quarter

1st. Report

Completion JUL 13 1953

Remarks Stoltenberg Pool

Ash-Mar - Contr.

Spudding Date 6-5-53

Drlg. Data Oil well TD 3214

8" @ 189 Anhy 445 Heeb. 2735

Br. lime 2852 Lens. 2872 Arb. 3211

TD 3214 5" @ 3212 CO to 3214

FU 2600' oil 12 hr. Comp. 35 bopd

J. G. MCGEHEE