

KANSAS

Form 51-5M-7-40-Palace


Ellsworth

Section 29 Township 17 Range 9-W

Well No. #8 Schroeder "A"

Company Cities Service Oil et al

NORTH Schroeder Pool

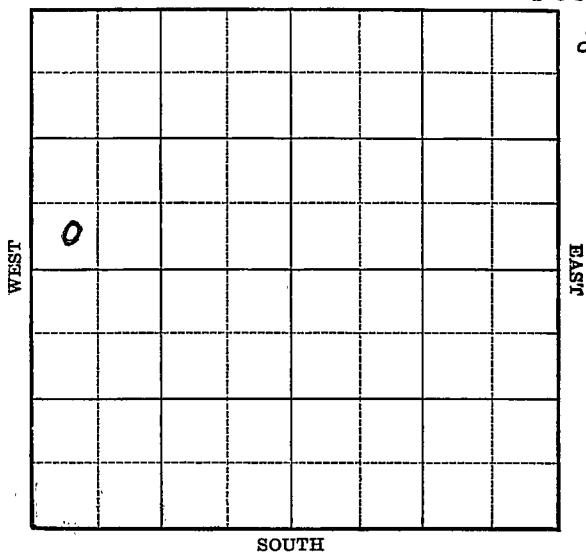

Map No. 45 Sec. 29 Twp. 17 R. 9WWell No. 8 Schroeder "A"Cities Service Oil etal Company**FIRST REPORT** Contractor

SW SW NW

SECTION PLAT Ft. from N. Line440 Ft. from S. Line Ft. from E. Line440 Ft. from W. Line**SCHROEDER POOL**

Location Rig up

Drilling and Remarks:

8" - 220WOC**RECORD**Cased in., ft.Sand Gas Oil Total Depth **PRODUCTION**1st 24 hrs. Nat. 1st 24 hrs. after shot Gas Cu. Ft.Dry Hole Abandoned

Date

OCT 9 1911S. J. LEWIS Scout

Map No. 45 Sec. 29 Twp. 17 R. 9W

Well No. 8 Schroeder "A"

Cities Service Oil et al Company

Contractor

COMPLETED

SW SW NW

 Ft. from N. Line

440 Ft. from S. Line

 Ft. from E. Line

440 Ft. from W. Line

SCHROEDER POOL

SECTION PLAT

Location

Rig up

Drilling and Remarks:

Per 8217

5" @ 8217

1000 @ 8217

Ech Per 4479

Nov 13000

RECORD

Cased in., ft.

Sand

Gas

Oil

Total Depth 8225

PRODUCTION

1st 24 hrs. Nat.

1st 24 hrs. after shot

Gas Cu. Ft.

Dry Hole

Abandoned

Date

OCT 30 1949 S. J. LEWIS Scout