


KANSAS

Ellsworth county

Section 29 Township 17 Range 9-W

Well No. #12 Schroeder "A"

Company Cities Service etal

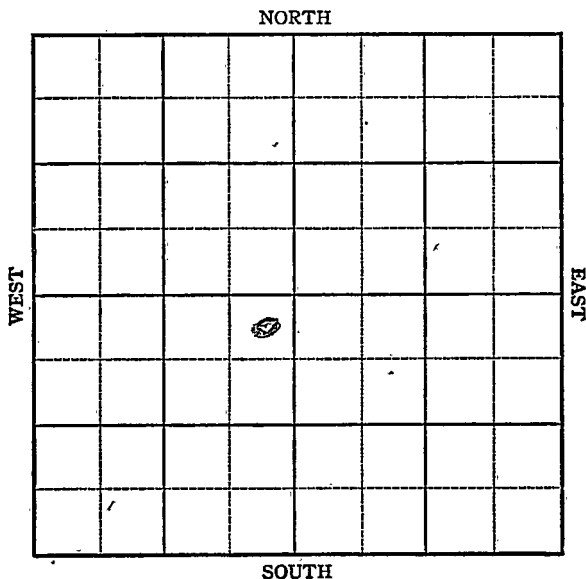

KANSAS

Ellsworth

Sec. 29 Twp. 17 R. 9-W

Well No. #12 Schroeder "A" Farm


Cities Service etal Company
Schroeder Pool

440 Ft. from N. Line

 Ft. from S. Line

440 Ft. from E. Line

 Ft. from W. Line

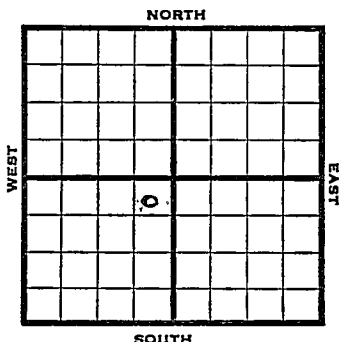

NE SW

1947 1769 REPORT

1/29 Drlg 270'

2/5 8" @ 285
Drlg 2565'

2/12 Lans 2885
Arb 3227
TD 3230'
5" @ 3228
RUST

2/19 Arb 3219'
Corrected
5" @ 3220-2440 f & oil 1/2 hrs

2/26 Arb 3219
5" @ 3220
Echo Pot 3000
Grav. 41.2
TD 3222'

COMPLETED

Kansas

KANSAS

Schroeder Pool

Map No. 45 Sec. 29 Twp. 17 R. 9WWell No. 12 Schroeder "A"Cities Service etal. Company

FIRST REPORT

Contractor

NE SW

SECTION PLAT

	o		

440 Ft. from N. Line Ft. from S. Line440 Ft. from E. Line Ft. from W. Line

Ellsworth County

Location Rig up

Drilling and Remarks:

270'

RECORD

Cased in., ft.Sand Gas Oil Total Depth

PRODUCTION

1st 24 hrs. Nat. 1st 24 hrs. after shot Gas Cu. Ft.Dry Hole Abandoned

Date

JAN 29 1947 19

S. J. LEWIS

Scout

Kansas

KANSAS

Schroeder Pool

Map No. 45 Sec. 29 Twp. 17 R. 9WWell No. 12 Schroeder "A"

Cities Service etal. Company

COMPLETE

Contractor

NE SW

E11769

SECTION PLAT

	6		

440 Ft. from N. Line

Ft. from S. Line

440 Ft. from E. Line

Ft. from W. Line

Ellsworth County

Location

Rig up

Drilling and Remarks:


RECORD

Cased _____ in., _____ ft.

Sand _____

Gas _____

Oil _____

Total Depth 3222

PRODUCTION

1st 24 hrs. Nat. _____

1st 24 hrs. after shot _____

Gas _____ Cu. Ft.

Dry Hole _____

Abandoned _____

Date

FEB 26 1947 19

S. J. LEWIS Scout