


FORM 51 IOM 12-46 PETROL

Section 29 Township 17 Range 9 W

Well No. #13 Schroeder "A"

Company Cities Service  
Lorraine

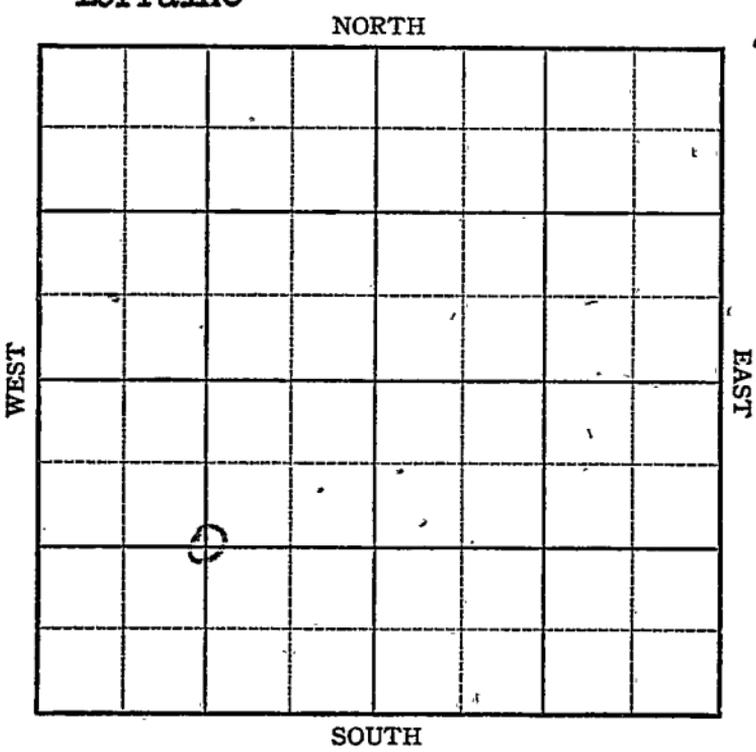



Sec. 29- Twp. 17 R. 9-W

Well No. #13 Schroeder "A" Farm

Cities Service Company


Lorraine Pool

1320 Ft. from N. Line.

\_\_\_\_\_ Ft. from S. Line

1320 Ft. from E. Line

\_\_\_\_\_ Ft. from W. Line

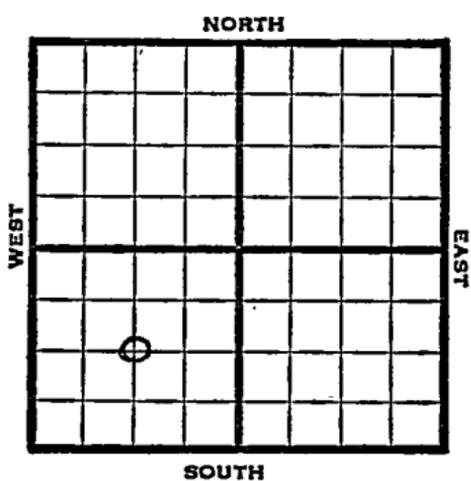

C SW

1947 Elev. 1767' REPORT

6/11 Location

6/18 8" @ 283  
Drlg 2130'

6/24 Arbuckle 3238'  
T.D. 3256'

7/2 Arb. 3238'  
TD 3268'

ABANDONED

Map No. \_\_\_\_\_ Sec. 29 Twp. 17 R. 9W

Well No. 13 Schroeder "A"

Cities Service Company

FIRST REPORT

Contractor

C SW


SECTION PLAT

1320 Ft. from N. Line

\_\_\_\_\_ Ft. from S. Line

1320 Ft. from E. Line

\_\_\_\_\_ Ft. from W. Line

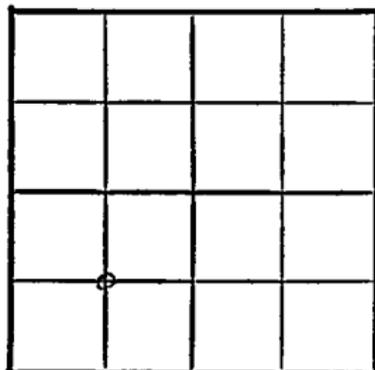

Ellsworth County

Location X

Rig up \_\_\_\_\_

Drilling and Remarks:

RECORD

Cased \_\_\_\_\_ in., \_\_\_\_\_ ft.

Sand \_\_\_\_\_

Gas \_\_\_\_\_

Oil \_\_\_\_\_

Total Depth \_\_\_\_\_

PRODUCTION

1st 24 hrs. Nat. \_\_\_\_\_

1st 24 hrs. after shot \_\_\_\_\_

Gas \_\_\_\_\_ Cu. Ft.

Dry Hole \_\_\_\_\_

Abandoned \_\_\_\_\_

Date

JUN 11 1947 19

S. J. LEWIS Scout

