

KANSAS

Ellsworth

Section 29 Township 17 Range 9WWell No. 14 Schroeder "A"Company Cities Service

Lorraine Pool

NORTH

WEST

EAST

0							

SOUTH

KANSAS

Ellsworth

Sec. 29 Twp. 17 R. 9W ✓

Well No. #14 Schroeder "A" Farm

Cities Service

Company

Lorraine Pool


440' Ft. from N. Line

_____ Ft. from S. Line

_____ Ft. from E. Line

400' Ft. from W. Line

NW/C

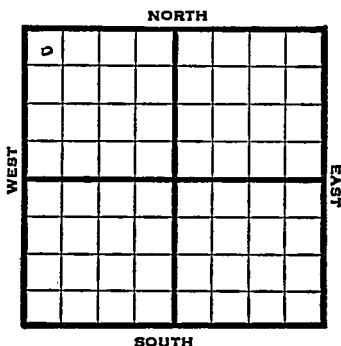

1948

Eli 1758' REPORT

9/15 Location

9/21 "

9/29 Drlg 115'

10/6 8" @ 150'

Drlg 2585'

10/13 Arb. 3203'

TD 3205'

5" @ 3204'

10/19 TD 3218'

10/27 TD 3218'

Arb. 3203'

5" @ 3204'

500 acid

Pump 101 oil / 25 W Pot

44° Gr.

Comp

COMPLETED

Ellsworth County Kansas State

Map No. _____ Sec. 29 Twp. 17 R. 9W

Well No. 14 Schroeder "A"

Cities Service Company

FIRST REPORT Contractor

NW/C

SECTION PLAT

440 Ft. from N. Line

_____ Ft. from S. Line

Ft. from E. Line

400 Ft. from W. Line


Lorraine Pool

Remarks:

Location

Date
SEP 15 1948

Scout **S. J. LEWIS**

Kansas

Map No. 45 Sec. 29 Twp. 17 R. 9WWell No. 14 Schroeder "A"

Cities Service

Company

COMPLETE


Contractor

NW/C

E. 1758
SECTION PLAT440 Ft. from N. Line

Ft. from S. Line

Ft. from E. Line

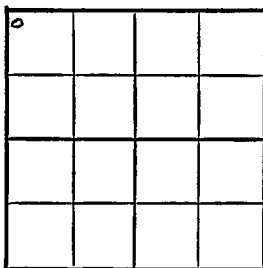400 Ft. from W. Line

Ellsworth County

Location

Rig up

Drilling and Remarks:

*Per 8203**5" 8204**5-0-0 acid**Pump 101 oil + 25W**8204**44 2/3*

RECORD

Cased _____ in., _____ ft.

Sand _____

Gas _____

Oil ☒Total Depth *2218*

PRODUCTION

1st 24 hrs. Nat. _____

1st 24 hrs. after shot _____

Gas _____

Cu. Ft. _____

Dry Hole _____

Abandoned _____

Date

OCT 27 1948 19

S. J. LEWIS

Scout