


Section 29 Township 17 Range 1 W

Well No. # 2 Tinkler

Company M. L. Brown et al

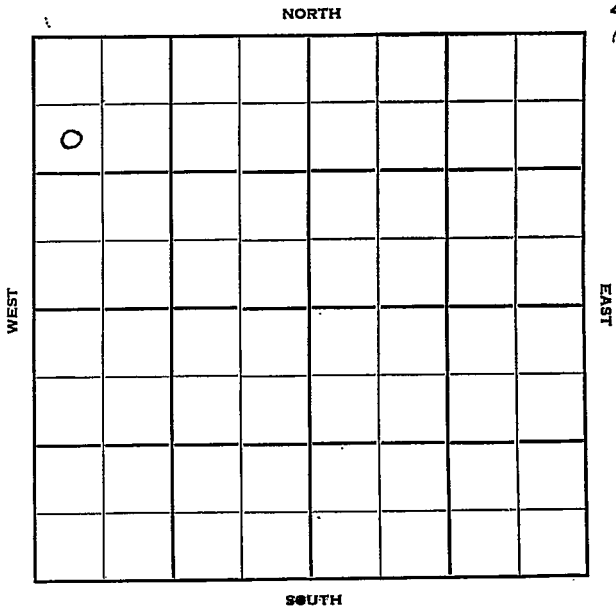

Sec. 29 Twp. 17 R. 1 W ✓

Well No. # 2 Tinkler Farm

M. L. Brown et al Company

Carey Drlg. Contractor

Roxbury Pool

NORTH


990 Ft. from N. Line

_____ Ft. from S. Line

_____ Ft. from E. Line

330 Ft. from W. Line

SW NW NW

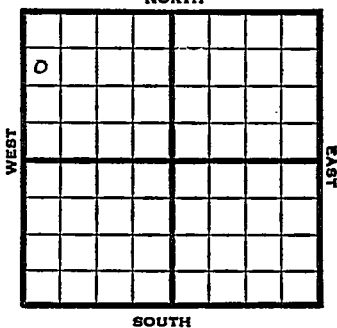

1951 Elev. 1379' REPORT

4/11 Spud 4-4-51
8" @ 132
Drlg. 1902'

5/9 Spud 4-4-51
Oil well TD 2706' 8" @ 132
Miss. 2692' 5" @ 2695' TD 2704'
1000 A DD 2706' 2000 A
Comp. 3½ BO 6 BWPD

COMPLETED

County **McPherson** State **Kansas**

Sec. **29** (Blk. **17** (Sur. **1W** (Twp.) Rge.) Map No.

Operator **M. L. Brown et al.**

Well No. **2** Farm **Tinkler**

Elev. Location **SW NW NW**

o							

990 Ft. From **N** Line **NW**

330 Ft. From **W** Line **Quarter**

Ist. Report **APR 11 1951**

Completion

Remarks

Carey Drlg. - Contr.

Spudding Date **4-4-51**

Drlg. Data **Roxbury Pool**

8" @ 132 drlg. 1902

County McPherson State Kansas

Sec. 29 (Blk. 17 (Sur. Rge.) 1W Map No.

Operator M. L. Brown etal.

Well No. 2 Farm Tinkler

Elev. 1379 Location -SW NW NW

o							
COMPLETE							

990 Ft. From N Line NW

330 Ft. From W Line Quarter

1st. Report

Completion MAY 9 1951

Remarks Roxbury Pool

Carey Drlg. - Contr.

Spudding Date 4-4-51

Drlg. Data Oil well TD 2706

8" @ 132 Miss. 2692 5" @ 2695

TD 2704 1000 A DD 2706 2000 A

Comp. 3½ bo 6 bwpd

J. E. TYRA