

KANSAS


FORM 51 5M 6-46 PETROL

Ellsworth County

Section. 3 Township 17 Range 10W

Well No. 1 Breford

Company B & R Drlg.

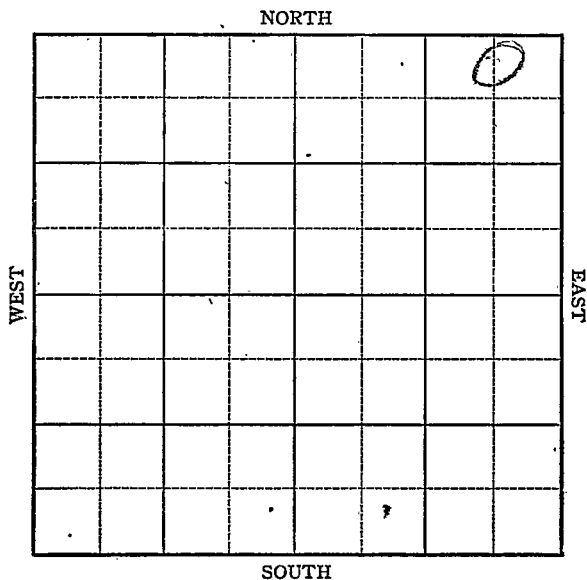


Sec. 3 'Twp. 17 R. 10WWell No. #1 Breford Farm
B & R Drlg. Company

Stotlenberg

330 Ft. from N. Line Ft. from S. Line660 Ft. from E. Line Ft. from W. Line

CNL NE NE

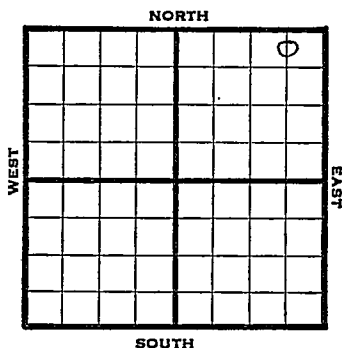

1946 Elev. 1829' REPORT

8/7 RUR
8/13 8" @ 365
Drlg 1610'
8/20 Lans 2962
Arb 3265
TD 3270
5" @ 3266 RUST
8/27 " "
9/5 TD 3291 $\frac{1}{2}$ -10 qts
3287-91-2000 acid
Swb 322 oil in 8 hrs
1250' off ---
9/10 " " "
9/18 Arb 3265'
5" @ 3266'
20 qts @ 3287-3291'
Acid 2000
Depth Pot 2525' no wtr.
Grav. 42
TD 3291 $\frac{1}{2}$

COMPLETED

KANSAS

Kansas

Pool Name Stoltenberg PoolMap No. 55 Sec. 3 Twp. 17 R. 10WWell No. 1 Breford

B & R Drlg.

Company

COMPLETED

Contractor

C N L NE NE

E 11829

SECTION PLAT

330 Ft. from N. Line Ft. from S. Line660 Ft. from E. Line Ft. from W. Line

			0

Ellsworth County

Location

Rig up

Drilling and Remarks:

Dr Y3265
 5" @ 3266
 209 to 3287-91
 2000 acid
 Sept 1925
 No W
 42 2/4

RECORD

Cased in., ft.Sand Gas Oil Total Depth 3287 1/2

PRODUCTION

1st 24 hrs. Nat. 1st 24 hrs. after shot Gas Cu. Ft.Dry Hole Abandoned

Date

SEP 18 1946 19

S. J. LEWIS

Scout


ANSAS Kansas Pool Name Stoltenberg
 Map No. 55 Sec. 3 Twp. 17 R. 10W
 Well No. 1 Breford

B & R Drlg. Company
FIRST REPORT

Contractor

C N L NE NE

SECTION PLAT

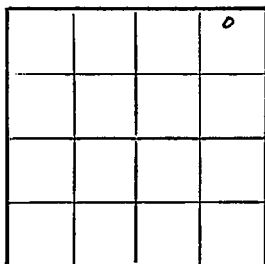

330 Ft. from N. Line

_____ Ft. from S. Line

660 Ft. from E. Line

_____ Ft. from W. Line

Ellsworth County

RECORD

Location _____

Cased _____ in., _____ ft.

Rig up _____

Sand _____

Drilling and Remarks:

Gas _____

R U R

Oil _____

Total Depth _____

PRODUCTION

1st 24 hrs. Nat. _____

1st 24 hrs. after shot _____

Gas _____ Cu. Ft.

Dry Hole _____

Abandoned _____

Date

AUG 7 1945 19 S. J. LEWIS Scout