

KANSAS Ellsworth

✓ 10W

Sec. 3 Twp. 17 R. _____

Well No. #1 Stoltenberg "C" Farm _____

B & R Drlg. Company _____


Stoltenberg Pool (B & R, Cont.)

990' Ft. from N. Line

_____ Ft. from S. Line

990' Ft. from E. Line

_____ Ft. from W. Line

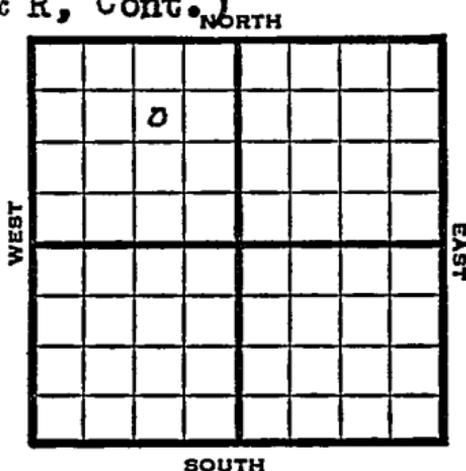

SW NE NW

SOUTH

1949 Elev 1806' REPORT

6/22 8" @ 345'
Drlg. 360'

6/28 Drlg 2858'

7/6 Lansing 2945'
Arbuckle 3260'
TD 3261'
5" @ 3260'

7/12 3266-500 acid
VSSO
TD 3272½
CO

7/20 A3266-500 acid
VSSO TD 3272½ CO

7/27 " "

8/3 3266-
500 acid
VSSO TD 3272½
CO

8/10 TD 3272½
Arb. 3260'
5"@ 3260'
2000 acid
Perf 50 oil / 40 W Pot
42.° Gr.
Comp

COMPLETED

Map No. _____ Sec. 3 Twp. 17 R. 10W

Well No. 1 Stoltenberg "C"

_____ B & R Drlg. _____ Company

_____ B & R _____ Contractor

SW NE NW

**FIRST REPORT
SECTION PLAT**

990 Ft. from N. Line

_____ Ft. from S. Line

990 Ft. from E. Line

_____ Ft. from W. Line

Ellsworth County

RECORD

Location _____

Cased _____ in., _____ ft.

Rig up _____

Sand _____

Drilling and Remarks:

Gas _____

8" @ 345

Oil _____

drlg. 360

Total Depth _____

PRODUCTION

1st 24 hrs. Nat. _____

1st 24 hrs. after shot _____

Gas _____ Cu. Ft.

Dry Hole _____

Abandoned _____

Date

JUN 22 1949

19

S. J. LEWIS

Scout

Kansas

Map No. K55 Sec. 3 Twp. 17 R. 10W

Well No. 1 Stoltenberg "C"

B & R Drlg. Company

Contractor

SW NE NW

E11806

SECTION PLAT

990 Ft. from N. Line

_____ Ft. from S. Line

990 Ft. from E. Line

_____ Ft. from W. Line

Elsworth ^{*oil*} County

RECORD

Location _____

Cased _____ in., _____ ft.

Rig up _____

Sand _____

Drilling and Remarks:

Gas _____

Oil _____

Total Depth 3272 1/2

PRODUCTION

1st 24 hrs. Nat. _____

1st 24 hrs. after shot _____

Gas _____ Cu. Ft.

Dry Hole _____

Abandoned _____

Date

AUG 10 1949 19

S. J. LEWIS Scout

CR 48260
5" CR260
2000 @ 200'
Prof. 30' to 6' 40 W
P.T.
42° SW