

KANSAS


FORM 51 IOM 12-46 PETROL

Ellsworth county

Section 3 Township 17 Range 10-W

Well No. #3, Breford

Company B & R Drilling Company

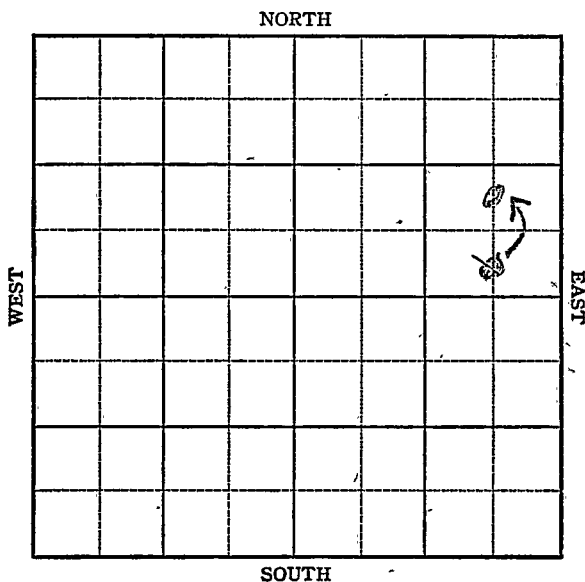

KANSAS

Ellsworth county

Sec. 3 Twp. 17 R. 10-W

Well No. #3, Breford Farm

B & R Drlg. Company Company  
Stoltenberg


         Ft. from N. Line

990  
330' Ft. from S. Line

660' Ft. from E. Line

         Ft. from W. Line

CNL SE NE  
CS L SE NE

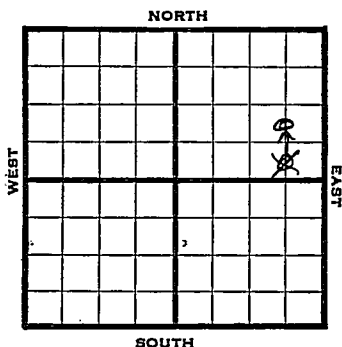

| 1946. | Elev. 1810' REPORT                             |
|-------|------------------------------------------------|
| 12/18 | 8" @ 322'<br>WOC                               |
| 1947  |                                                |
| 1/4   | Arb 3260'<br>TD 3266' stain<br>5" @ 3263, RUST |
| 1/8   | " "                                            |
| 1/15  | " "                                            |
| 1/21  | " "                                            |
| 1/30  | TD 3278'<br>2000 Acid<br>Swb 4 oil PH          |
| 2/5   | " " "                                          |
| 2/12  | " " "                                          |
| 2/19  | " " "                                          |
| 2/26  | Pump 125 bbl's fluid pr day 98% water          |
| 3/4   | TD 3278'<br>SD                                 |
| 3/11  | TD 3278'                                       |

OVER

3/18 TD 3278' SD

3/25 TD 3294 $\frac{1}{2}$ ' squeeze  
PB 3273'  
WOC

4/2 12 qts. 3269-73'  
2000 Acid  
Swb. 5 bbls. oil P H 5 hrs.

4/9 Swb 3 bbls oil PH

4/16 Arb. 3260'  
5" @ 3263  
PB 3273  
2000 Acid  
12 qts 3269-73  
Pump 86 oil & 10% W Pot  
Grav. 42  
TD 3294 $\frac{1}{2}$ '

**COMPLETED**

3260  
1818  

---

-1442

Map No. \_\_\_\_\_ Sec. 3 Twp. 17 R. 10WWell No. 3 BrefordB & R Drlg. Company**FIRST REPORT**

Contractor

C S L SE NE

**SECTION PLAT**

\_\_\_\_\_ Ft. from N. Line

330 Ft. from S. Line660 Ft. from E. Line

\_\_\_\_\_ Ft. from W. Line

*W. J. S. L.*

Ellsworth County

|  |  |  |   |
|--|--|--|---|
|  |  |  |   |
|  |  |  |   |
|  |  |  | o |
|  |  |  |   |
|  |  |  |   |

Location \_\_\_\_\_

Rig up \_\_\_\_\_

Drilling and Remarks:

8" @ 322 WOC**RECORD**

Cased \_\_\_\_\_ in, \_\_\_\_\_ ft.

Sand \_\_\_\_\_

Gas \_\_\_\_\_

Oil \_\_\_\_\_

Total Depth \_\_\_\_\_

**PRODUCTION**

1st 24 hrs. Nat. \_\_\_\_\_

1st 24 hrs. after shot \_\_\_\_\_

Gas \_\_\_\_\_ Cu. Ft.

Dry Hole \_\_\_\_\_

Abandoned \_\_\_\_\_

Date

DEC 1 8 1946 19S. J. LEWIS Scout

55

Misc. Small Maps 10/11

Cards Suzak

Tracing JP

France Map JP

Scarborough Map JP

Pierce Map JP

Logical Dept. JP

Plat Book JP

Kansas

KANSAS

Map No. 55 Sec. 3 Twp. 17 R. 10WWell No. 3 Breford

B &amp; R Drlg.


Company

CORRECTION

Contractor

C N L SE NE

## SECTION PLAT

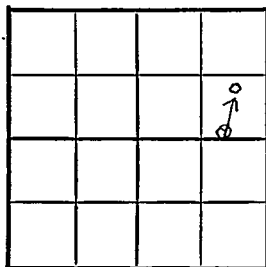

Ft. from N. Line

990 Ft. from S. Line

660 Ft. from E. Line

Ft. from W. Line

*offset*

Ellsworth County

Location

Rig up

Drilling and Remarks:

Reported

C S L SE NE

## RECORD

Cased \_\_\_\_\_ in., \_\_\_\_\_ ft.

Sand \_\_\_\_\_

Gas \_\_\_\_\_

Oil \_\_\_\_\_

Total Depth \_\_\_\_\_

## PRODUCTION

1st 24 hrs. Nat. \_\_\_\_\_

1st 24 hrs. after shot \_\_\_\_\_

Gas \_\_\_\_\_ Cu. F

Dry Hole \_\_\_\_\_

Abandoned \_\_\_\_\_

Date

JAN 2 1947 19

S. J. LEWIS

Misc. Small Maps

Cards -

Tracing

France Map

Scarborough Map

Pierce Map

Geological Dept.

Pierce Plat Book

Kansas KANSAS

Map No. K 55 Sec. 3 Twp. 17 R. 1 OWWell No. 3 Breford

B &amp; R Drlg.

Company

COMPLETE

Contractor

C N L SE NE

E. 1970  
SECTION PLAT       Ft. from N. Line990 Ft. from S. Line660 Ft. from E. Line       Ft. from W. Line

|  |  |  |   |
|--|--|--|---|
|  |  |  |   |
|  |  |  | o |
|  |  |  |   |
|  |  |  |   |

Ellsworth County

Location

Rig up

Drilling and Remarks:

*Cor 83260**5" @ 3263**P/B 3273.**2000 aad**129 to 3269-73**Pumps 86 oil + 10 75**Box.**42.2 Gr*

## RECORD

Cased        in,        ft.Sand       Gas       Oil       Total Depth 3294 1/2

## PRODUCTION

1st 24 hrs. Nat.       1st 24 hrs. after shot       Gas        Cu. Ft.Dry Hole       Abandoned       

Date

APR. 16 1947

19

S. J. LEWIS

Scout

*[Handwritten signature]*

|                  |                   |
|------------------|-------------------|
| Misc. Small Maps | <i>[initials]</i> |
| Cards            | <i>[initials]</i> |
| Tracing          | <i>[initials]</i> |
| France Map       | <i>[initials]</i> |
| Scarbbrough Map  | <i>[initials]</i> |
| Pierce Map       | <i>[initials]</i> |
| Geological Dept. |                   |
| Pierce Plat Book |                   |