


FORM 51 IOM 12-46 PETROL

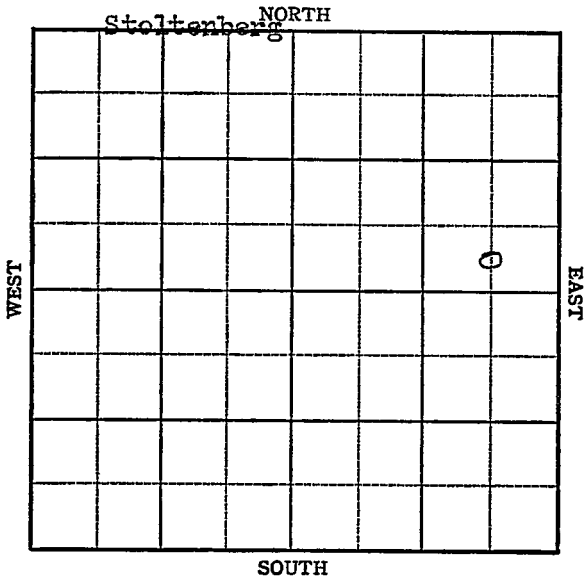

KANSAS Ellsworth ✓

Sec. 3 Twp. 17 R. 10W

Well No. #4 Breford Farm

B. & R. Drlg. et al Company
Stoltenberg


 Ft. from N. Line

330 Ft. from S. Line

660 Ft. from E. Line

 Ft. from W. Line

C S L SE NE

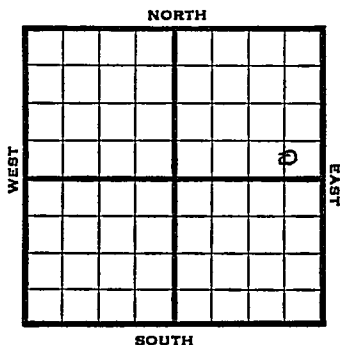

1947

Elev. 1801

R E P O R T

8/27

8" @ 345'
Heebner 2810'
Lansing 2930'
Cong. 3236'
Arb. 3243'
TD 3245'
5" @ 3243'

9/3 TD 3250 10 Qts. 3245-49 pipe collapsed

9/10

"

9/177

"

9/24

"2

10/1

500 acid
Pump 1½ bbls. oil PH
Drill deeper.

10/8

Arbuckle 3243'.
5" @ 3243'
4,000 Acid
TD 3253'

ABANDONED


Map No. _____ Sec. 3 Twp. 17 R. 10WWell No. 4 Breford

_____ B & R Drlg. etal. _____ Company

_____ **FIRST REPORT** _____ Contractor

C S L SE NE

SECTION PLAT

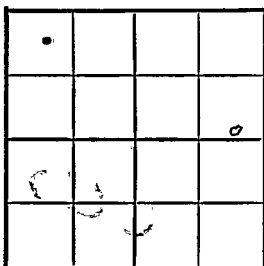

_____ Ft. from N. Line

330 Ft. from S. Line660 Ft. from E. Line

_____ Ft. from W. Line

Ellsworth County

Location _____

Rig up _____

Drilling and Remarks:

8" @ 345

Heebner 2810

Lans. 2930

Cong. 3236

Arb. 3243

TD 3245

5" @ 3243

RECORD

Cased _____ in., _____ ft.

Sand _____

Gas _____

Oil _____

Total Depth _____

PRODUCTION

1st 24 hrs. Nat. _____

1st 24 hrs. after shot _____

Gas _____ Cu. Ft.

Dry Hole _____

Abandoned _____

Date

AUG 27 1947

19

S. J. LEWIS

Scout

Form 26 200 Bks. 10-46 Petrol
KansasMap No. 55 Sec. 3 Twp. 17 R. 10WWell No. 4 BrefordB & R drlg. etal. Company

ABANDONED

Contractor

C S L S E N E

E1, 1801
SECTION PLAT Ft. from N. Line330 Ft. from S. Line660 Ft. from E. Line Ft. from W. Line

			0

Ellsworth County

Location Rig up

Drilling and Remarks:


RECORD

Cased in., ft.Sand Gas Oil Total Depth 02053

PRODUCTION.

1st 24 hrs. Nat. 1st 24 hrs. after shot Gas Cu. Ft.Dry Hole Abandoned

Date

OCT 8 1947 19 S. J. LEWIS Scout