
FORM 51 SM 11-44 PETROL KANSAS Ellsworth County

Section 3 Township 17 Range 10W

Well No. #1 ~~Breford~~ Stoltenberg

Company Herndon Drlg.

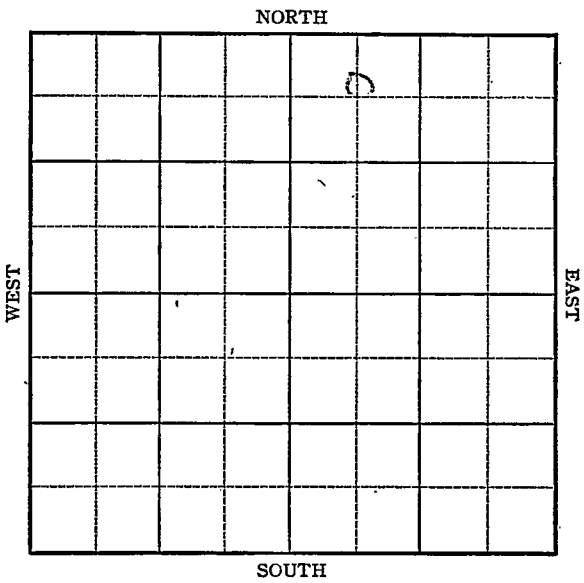

FORM 252-A
5M 9-45 PETROL

Ellsworth County

Sec. 3 KANSAS Twp. 17S R. 10W

Well No. #1, ~~Breford~~ Stoltenberg Farm

Herndon Drilling Company

C NW NE


510 Ft. from N. Line

_____ Ft. from S. Line

_____ Ft. from E. Line

660 Ft. from W. Line

Elev. 1792

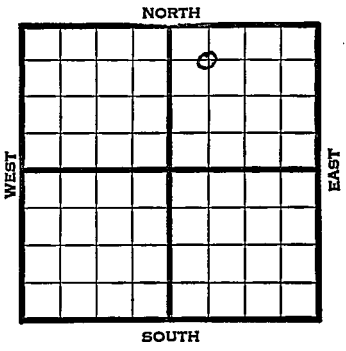

1945	REPORT
4-4	Location
4/12	RUR
4/20	8" @ 340 Arb 3238 SO 5" @ 3238 TD 3248-150' oil
4/27	500 acid. Swab 3 oil per hr.
5/3	" " " " "
5/10	5 qts. 3240-3248 CO
5/17	" " " " "
5/23	Arb. 3238 5" @ 3238 5 qts. 3240-3248 500 acid. TD 3248 Pump 225 Pot. Grav. 42.0

COMPLETED

FORM 26 200 BKS 1-44 PETROL

Pool Name Stoltenberg

Map No. K55 Sec. 3 Twp. 17 R. 10W

Well No. 1 Brefford

Herndon Drlg. Company

FIRST REPORT Contractor

C NW NE

510 Ft. from N. Line


Ft. from S. Line

Ft. from E. Line

660 Ft. from W. Line

Ellsworth

SECTION PLAT

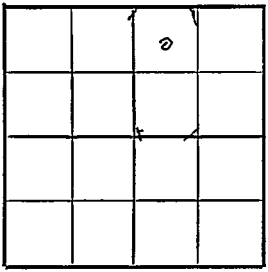

Location X

Rig up

Drilling and Remarks:

RECORD

Cased in., ft.

Sand

Gas

Oil

Total Depth

PRODUCTION

1st 24 hrs. Nat.

1st 24 hrs. after shot

Gas Cu. Ft.

Dry Hole

Abandoned

Date

APR 4 1945 19 S. J. LEWIS Scout

FORM 26 200 BKS 1-44 PETROL

Kansas Pool Name Stoltenberg

Map No. 5-5 Sec. 3 Twp. 17 R. 10W

Well No. 1 Stoltenberg

Herndon Drlg. Company

CORRECTION Contractor

C NW NE

510 Ft. from N. Line


Ft. from S. Line

Ft. from E. Line

660' Ft. from W. Line Clear Clear

Ellsworth County

SECTION PLAT

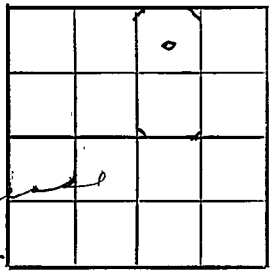

Location

Rig up

Drilling and Remarks:

reported as
#1 Bfeford

RECORD

Cased in., ft.

Sand

Gas

Oil

Total Depth

PRODUCTION

1st 24 hrs. Nat.

1st 24 hrs. after shot

Gas Cu. Ft.

Dry Hole

Abandoned

Date

APR 18 1945 19 S. J. LEWIS Scout

FORM 26 200 BKS 2-44 PETROL

Kansas Pool Name Stoltenberg

Map No. 55 Sec. 3 Twp. 17 R. 10W


Well No. 1 Stoltenberg

Herndon Drlg. Company
COMPLETED

Contractor

C NW NE

E 1.1792
SECTION PLAT

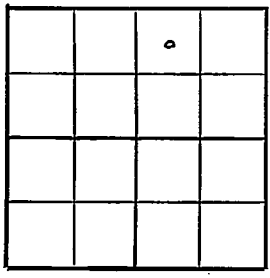

510 Ft. from N. Line

Ft. from S. Line

Ft. from E. Line

660 Ft. from W. Line

Ellsworth County

Location

Rig up

Drilling and Remarks:

Cer # 3238
5" C 3238.
5 pts 3240-48
Sd Acid
Pump 225 B.W.
42° Gr

RECORD

Cased in., ft.

Sand

Gas

Oil

Total Depth 3248'

PRODUCTION

1st 24 hrs. Nat.

1st 24 hrs. after shot

Gas Cu. Ft.

Dry Hole

Abandoned

Date

MAY 23 1945 19 S. J. LEWIS Scout