

KANSAS

Ellsworth

Section 3 Township 17 Range 10W

Well No. 2A ~~B~~ Stoltenberg

Company Bennett & Roberts

Stoltenberg

NORTH

	0		.				

WEST

EAST

SOUTH

HOT FILE

Ellsworth

KANCA ✓


Sec. 3 Twp. 17 R. 10W

Well No. #2 Stoltenberg "A" Farm

Bennett & Roberts Company

Stoltenberg Pool

NORTH

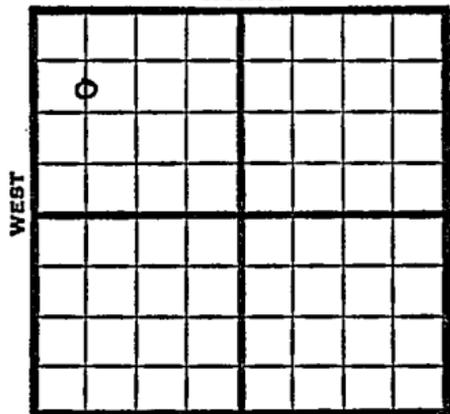

990' Ft. from N. Line

_____ Ft. from S. Line

_____ Ft. from E. Line

660' Ft. from W. Line

C S L NW NW

CLOSE TO OUR ACREAGE

SOUTH

1949

Elev 1817'

REPORT

7/6

8" @ 387'

Anhy 582'

Drlg. 2150'

7/12

Lansing 2955'

Drlg 3042'

7/27

"

8/3

TD 3279

15000cid

Swb 24 bbls oil 12 hrs.

8/10

TD 3279½

Arb. 3269'

5" @ 3270'

Pump 60 Oil Pot

41° Gr.

Comp

COMPLETED

Map No. _____ Sec. 3 Twp. 17 R. 10W

Well No. 3 Stoltenberg

Bennett & Roberts Company

B & R Contractor

C S L NW NW

FIRST REPORT
SECTION PLAT

990 Ft. from N. Line

_____ Ft. from S. Line

_____ Ft. from E. Line

660 Ft. from W. Line

Ellsworth County

Location _____

Rig up _____

Drilling and Remarks:

8" @ 387

Anhy 582

drlg. 2150

RECORD

Cased _____ in., _____ ft.

Sand _____

Gas _____

Oil _____

Total Depth _____

PRODUCTION:

1st 24 hrs. Nat. _____

1st 24 hrs. after shot _____

Gas _____ Cu. Ft.

Dry Hole _____

Abandoned _____

Date

JUL 6 1949 19

S. J. LEWIS Scout

Scout Cards
Land Small Map
Land Wall Map
Tracings
France Map
Pierce Map
Misc.

Kansas

Stoltenberg Pool

Map No. K55 Sec. 3 Twp. 17 R. 10WWell No. 2 Stoltenberg "A"

Bennett & Roberts _____ Company

CORRECTION_____
Contractor

G S L NW NW

SECTION PLAT

990 Ft. from N. Line

_____ Ft. from S. Line

_____ Ft. from E. Line

660 Ft. from W. Line

Ellsworth County

Location _____

Rig up _____

Drilling and Remarks:

Reported as
#3 Stoltenberg

RECORD

Cased _____ in., _____ ft.

Sand _____

Gas _____

Oil _____

Total Depth _____

PRODUCTION

1st 24 hrs. Nat. _____

1st 24 hrs. after shot _____

Gas _____ Cu. Ft.

Dry Hole _____

Abandoned _____

Date

JUL 20 1949 19S. J. LEWIS Scout

Sandy - -

Please correct
twop. - -

Eddie

Scout Cards	✓
Land Snail Map	✓
Land Wall Map	✓
Tracings	✓
Frame Map	✓
Pierce Map	✓
Misc.	

Map No. K 55 Sec. 3 Twp. 17 R. 10W

Well No. 2 Stoltenberg "A"

Bennett & Roberts Company

COMPLETE

Contractor

C S L NW NW

E 11877
SECTION PLAT

990 Ft. from N. Line

_____ Ft. from S. Line

_____ Ft. from E. Line

660 Ft. from W. Line

Ellsworth County

RECORD

Location _____

Cased _____ in., _____ ft.

Rig up _____

Sand _____

Drilling and Remarks:

Gas _____

Oil _____

Total Depth 3279 1/2

Cur 3269

5" @ 3270

Plug 60 oil Prod.

PRODUCTION

1st 24 hrs. Nat. _____

1st 24 hrs. after shot _____

Gas _____ Cu. Ft.


Dry Hole _____

Abandoned _____

H 10/2

Date

AUG 10 1949 19 _____ S. J. LEWIS Scout

 


Scout Cards	10
Land Small Map	1
Land Wall Map	1
Tracings	1
France Map	1
Pierce Map	3
Misc.	

1010