

Section 3 Township 17 Range 10W

Well No. 3 Stollenberg "A"

Company B & R Drlg.

Stollenberg
 NORTH

0							

WEST

EAST

SOUTH

HOT FILE Ellsworth KANSAS

Sec. 3 Twp. 17 R. 10W ✓Well No. #3 Stollenberg "A" Farm

B & R Drlg. Company

Stollenberg(B & R Drlg., Cont.) NORTH
Pool


Ft. from N. Line

990' Ft. from S. Line

Ft. from E. Line

330' Ft. from W. Line

NW SW NW

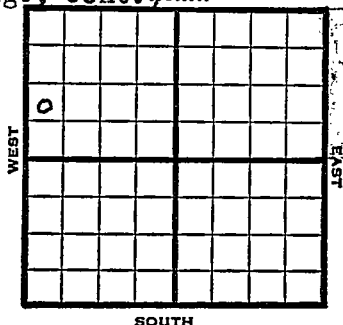

1949

Elev. 1877' REPORT

7/20

8" @ 391'

Anhy 587'

Drlg. 1450'

7/27

Arb. 3267-70'

TD 3270'

5" @ 3268'

8/3

"

8/10

TD 3285'

13 qts 3280-85

3500 acid

8/17

"

8/24

"

8/31

Arb 3267'

5" @ 3268'

13 qts

Acid 3500

Pump 25 oil Pot.

Grav. 42°

TD 3285'

COMPLETED

Stollenberg Pool

Map No. _____ Sec. 3 Twp. 17 R. 10W

Well No. 3 Stollenberg "A"

9 B & R Drlg.

Company

B & R Drlg.

Contractor

NW SW NW

**FIRST REPORT
SECTION PLAT**

o			

_____ Ft. from N. Line

990 _____ Ft. from S. Line

_____ Ft. from E. Line

330 _____ Ft. from W. Line

Ellsworth County

Location _____

Rig up _____

Drilling and Remarks:

8" @ 391

an by 587

1450

RECORD

Cased _____ in., _____ ft.

Sand _____

Gas _____

Oil _____

Total Depth _____

PRODUCTION

1st 24 hrs. Nat. _____

1st 24 hrs. after shot _____

Gas _____ Cu. Ft.

Dry Hole _____

Abandoned _____

Date

JUL 20 1949 19

S. J. LEWIS

Scout

Scout Cards

Land Small Map

Land Wall Map

Tracings

France Map

Pierce Map

Misc.

Kansas

Map No. K55 Sec. 3 Twp. 17 R. 10WWell No. 3 Stoltenberg "A"

B & R Drlg.

Company

COMPLETE

Contractor

NW SW NW

E. 1877
SECTION PLAT

4			

Ft. from N. Line

990 Ft. from S. Line

Ft. from E. Line

330 Ft. from W. Line

Ellsworth County

Location

Rig up

Drilling and Remarks:

*Cur 3267**5" 3265**187 ft**3500 cu ft**Prod 25 oil 1st**42° E*

RECORD

Cased _____ in. _____ ft.

Sand _____

Gas _____

Oil _____

Total Depth *2200*

PRODUCTION

1st 24 hrs. Nat. _____

1st 24 hrs. after shot _____

Gas _____ Cu. Ft.

Dry Hole _____

Abandoned _____

Date

AUG 31 1949

19

S. J. LEWIS

Scout

Sandy =

First Report Shows
#3 well Advise

Eddie

Scout Cards	OK
Land Small Map	
Land Wall Map	
Tracings	
France Map	
Pierce Map	
Misc.	