

Section 3 Township 17 Range 10WWell No. 3 SiensenCompany B & R Drlg.

NORTH

SOUTH

WEST

EAST

0

KANSAS

WELL NO. _____

FARM

COMPANY

CONTRACTOR

Stoltenberg Pool

990

Ft. from N. Line


Ft. from S. Line

330

Ft. from E. Line

Ft. from W. Line

SE NE SE
SWDW

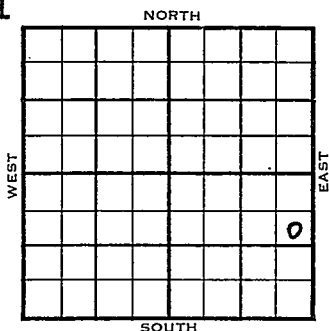

1953

ELEVATION:

1

REPORT

9/16

Spud 9-1-53

TD 3778

7" @ 3408'

9/23

Spud9-1-53

SWD Well

TD 3778:

Arb. 3247, Granite 3776

TD 3778

7" @ 3408'

CO to 3778'

HFV in 3 min

Comp. for SWD Well.

ABANDONED

County Ellsworth State Kansas

Sec. 3 (Blk. Twp.) 17 (Sur. Rge.) 10W Map No.

Operator **B & R Drilling**

Well No. 3 Farm Siemsen

Elev. ..	Location	SE NE SE
----------	----------	----------

FIRST REPORT 0

990 Ft. From N Line SE

330 Ft. From E Line Quarter

1st. Report SEP 16 1953

Completion

Remarks SWDW


B & R Drlg. - Contr.

Spudding Date **9-1-53**

Drig. Data	Stoltenberg Pool
------------	------------------

TD 3778 7th @ 3408

County Ellsworth State Kansas
 Sec. 3 (Blk. 17 (Sur. 10W Map No.
 (Twp. (Rge.
 Operator B & R Drlg.
 Well No. 3 Farm Siemens
 Elev. Location SE NE SE

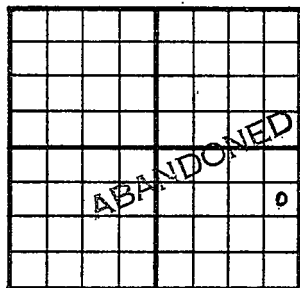

990 Ft. From N Line SE
330 Ft. From E Line Quarter
 1st. Report
 Completion SEP 23 1953
 Remarks Stoltenberg Pool
B & R Drlg. - Contr.
 Spudding Date 9-1-53

Drlg. Data SWD well TD 3778
Arb. 3247 Granite 3776 TD 3778
7" @ 3408 CD to 3778. HFW in 3 min.
Comp. for SWD well