

Ellsworth

KANSAS

Section 30 Township 17 Range 9-WWell No. 1 Schroeder "B"Company Cities Service Oil

							0

NORTH

WEST


EAST

SOUTH

KANSAS - Ellsworth

Sec. 30 Twp. 17 R. 9-WWell No. #1 Schroeder "B" FarmCities Service Oil Company440 Ft. from N. Line Ft. from S. Line440 Ft. from E. Line Ft. from W. Line

Elev. 1768'.

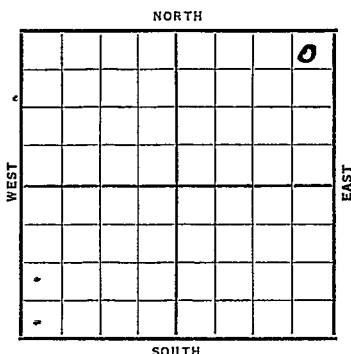

Date	REPORT
1938	
2/2	Location
2/11	R U R
2/18	10" @ 258'. Drlg. 2035'.
2/26	K.C. 2890'. Drlg. 3053'.
3/4	Cherty Cong. 3205'.
	Arb. 3228'. 7" @ 3230'.
	T.D. 3238'. Sat. Core.
	RUST.
3/11	T.D. 3242'. 1200' oil.
3/18	1500 acid. Pump 31 oil &
	362 water in 6½ hrs.
	S. D. O.
3/23	TD 3242'.
	S. D. O.
4/1	" "
4/8	" "
4/15	" "
4/22	" "
4/29	" "
5/6	" "
	OVER

1938

5/12 TD 3242' SD.

5/20 " "

5/25 7" @ 3230'.

Arb. 3228'.

T.D. 3242'.

ABANDONED

Map No. _____ Sec. 30 Twp. 17 R. 9WWell No. 1 Schroeder "B"Cities Service Oil Company

Contractor _____

FIRST REPORT

NE/C

440 Ft. from N. Line

_____ Ft. from S. Line

440 Ft. from E. Line

_____ Ft. from W. Line

SECTION PLAT

			0

Location X

Rig up _____

Drilling and Remarks:

RECORD

Cased _____ in., _____ ft.

Sand _____

Gas _____

Oil _____

Total Depth _____

PRODUCTION

1st 24 hrs. Nat. _____

1st 24 hrs. after shot _____

Gas _____ Cu. Ft.

Dry Hole _____

Abandoned _____

Date

FEB 2 1938 19 _____ H. D. Hatfield Scout

Ellsworth KANSAS

Map No. 45 Sec. 30 Twp. 17 R. 9WWell No. 1 Schroeder "B"Cities Service Oil etal Company

Contractor

ABANDONED
NE/C

SECTION PLAT

			0

440 Ft. from N. Line Ft. from S. Line440 Ft. from E. Line Ft. from W. LineLocation Rig up

Drilling and Remarks:

D & A

RECORD

Cased 7 in., 3230 ft.Sand Arb 3228Gas Oil Total Depth 3242

PRODUCTION

1st 24 hrs. Nat. 1st 24 hrs. after shot Gas Cu. Ft.Dry Hole Abandoned

Date

MAY 25 1938

19

H. D. Hatfield

Scout