

KANSAS

Form 51—5M—7-40—Palace

Ellsworth

Section 30 Township 17 Range 9-W

Well No. #1 Schroeder

Company Mudge Oil

NORTH Wilkins Pool

8

							0

WEST


EAST

SOUTH

(Wilkins)

Ft. from W. Line

Elev. 1760

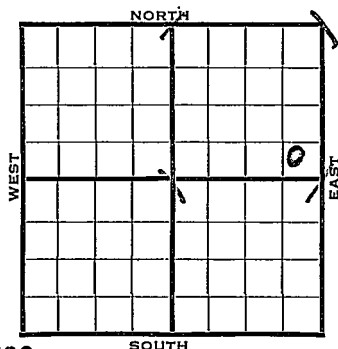

1940	REPORT
7/31	Rotary Derrick.
8/8	Surface hole.
8/14	10" 207 -Ark 445'
	Drlg. 1675'
8/22	Lansing 2850' Drlg. 3100'
8/29	Arb. 3210' ^{3212'} T.D. 3213'
	5" - 3210' ^{3212'} RUST.
9/5	T.D. 3216' 3050' oil.
	Pump 19 bbls. per hr. 4 hours.
9/11	Arb. 3212' (Corrected)
	5" - 3212'
	T.D. 3216'
	1000 acid.
	Potential 120 bbls., pump.
	COMPLETED

Map No. 45 Sec. 30 Twp. 17 R. 9WWell No. 1 SchroederMudge Oil

Company

Contractor


FIRST REPORT

SE NE

 Ft. from N. Line440 Ft. from S. Line440 Ft. from E. Line Ft. from W. Line

WILKINS POOL

SECTION PLAT

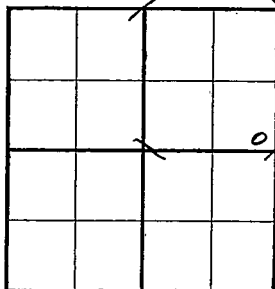Location Rig up

Drilling and Remarks:

Rotary derrick

RECORD

Cased in., ft.Sand Gas Oil Total Depth

PRODUCTION

1st 24 hrs. Nat. 1st 24 hrs. after shot Gas Cu. Ft.Dry Hole Abandoned

Date

JUL 31 1940 19S. J. LEWIS Scout

Map No. 45 Sec. 30 Twp. 17 R. 9WWell No. 1 SchroederMudge Oil

Company

Contractor

COMPLETED

SE NE

 Ft. from N. Line440 Ft. from S. Line440 Ft. from E. Line Ft. from W. Line**SECTION PLAT**

WIIKINS POOL

Location Rig up

Drilling and Remarks:

*Cor 8212 corrected**5" @ 8212**1000 acid**Pump 120 Pst.***RECORD**Cased in., ft.Sand Gas Oil Total Depth 3216**PRODUCTION**1st 24 hrs. Nat. 1st 24 hrs. after shot Gas Cu. Ft.Dry Hole Abandoned

Date

SEP 11 1940 19

S. J. LEWIS Scout