


Section 30 Township 17 Range 9W

Well No. #1 Mollhagen

Company Derby Drlg.

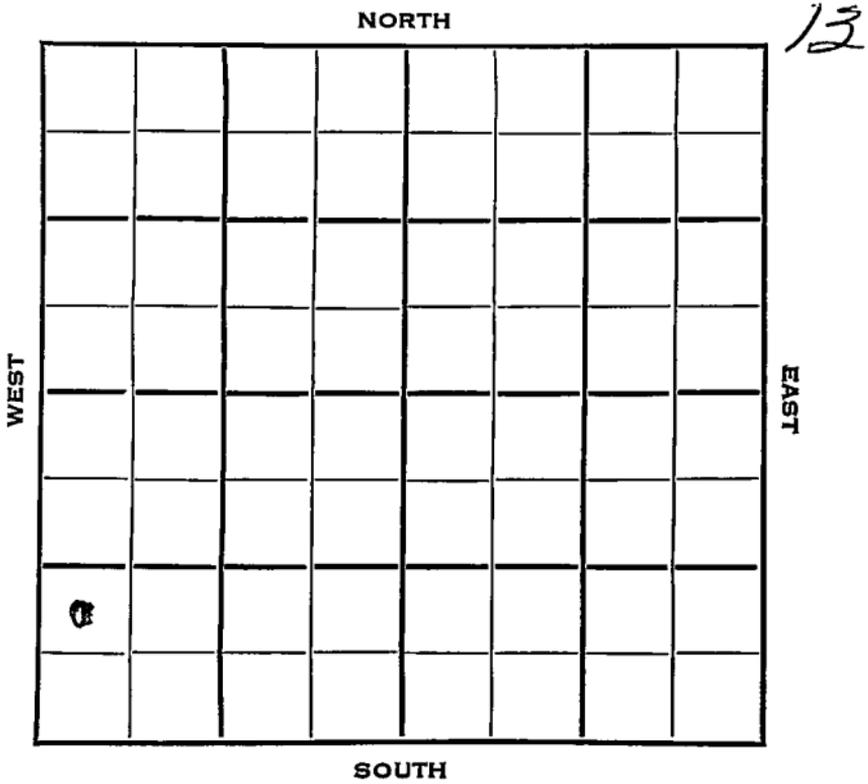

County Ellsworth State KansasSec. 30 (Blk.
Twp.) 17 (Sur.
Rge.) 9W Map No.Operator Derby Drlg.Well No. 1 Farm MollhagenElev. 1751 Location NW SW SW

990 Ft. From S Line SW330 Ft. From W Line Quarter

1st. Report

Completion MAY 5 1954Remarks Heiken PoolRocket Drlg. - Contr.Spudding Date 4-3-54Drlg. Data Oil well TD 32808" @ 185 Heeb. 2744 Br. lime 2854Lans. 2876 DST 2890-2937 open 1 hr.Rec. 540' gas 85' gcm 180#.Cong. 3192 Arb. 3241 TD 32805 $\frac{1}{2}$ " @ 3279 CO to 3263 84/ 3192-3217S/ 52 bo 9 hr. S/ 5 $\frac{1}{2}$ bophComp. 132 bopd