Ellsworth

DX 78-1

KANSAS

Section 30 Township 17 Range 9W

Well No. #2 Mollhagen

Company ~~Derby Drlg.~~

13

NORTH

WEST

EAST

SOUTH

Ellsworth KANSAS

SEC.	TWP.	R.
30	17	9 W

WELL NO.

2 Mollhagen FARM

COMPANY

Derby Drlg.

CONTRACTOR

Rocket Drlg.

Heiken Pool

_____ Ft. from N. Line

330 Ft. from S. Line

_____ Ft. from E. Line

330 Ft. from W. Line

SW SW SW

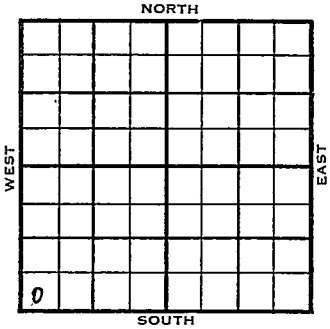

1954	ELEVATION 1750' REPORT
9/8	Spud 9-4-54 8" @ 184 Drlg. 1970'
11/10	Spud 9-4-54 - Oil Well TD 3229' 8" @ 184' Heeb 2740', Br lime 2852', Lans 2875', Cong. 3192', Arb. 3215' ~~WX~~ TD 3226' 5" @ 3226' DD 3229' S/3 boph 7 hrs., SP 3215 94/3193-3211, 1 goph Sd-oil0frac P/53 bo 67 bw 24 hrs. Comp. 33 bopd 67% wtr.

COMPLETED

DX-78

FORM 275 FOR SALE BY KANSAS BLUE PRINT CO.

County Ellsworth State ~~Kansas~~

Sec. 30 (Blk. Twp.) 17 (Sur. Rge.) 9W Map No.

Operator Derby Drlg.

Well No. 2 Farm Mollhagen

Elev. Location SW SW SW

0							

FIRST REPORT

330 Ft. From S Line SW Quarter

330 Ft. From W Line

1st. Report SEP 8 1954

Completion

Remarks

Rocket Drlg. - Contr.

Spudding Date 9-4-54

Drlg. Data Heiken Pool

8" @ 184 drlg. 1970

FABEN GILSTRAP

FORM 275 FOR SALE BY KANSAS BLUE PRINT CO.

County Ellsworth State Kansas

Sec. 30 (Blk. Twp.) 17 (Sur. Rge.) 9W Map No.

Operator Derby Drlg.

Well No. 2 Farm Mollhagen

Elev. 1750 Location SW SW SW

COMPLETE

330 Ft. From S Line SW Quarter

330 Ft. From W Line

1st. Report

Completion NOV 10 1954

Remarks Heiken Pool

Rocket Drlg. - Contr.

Spudding Date 9-4-54

Drlg. Data Oil well TD 3229

8" @ 184 Heeb. 2740 Br. lime 2852

Lans. 2875 Cong. 3192 Arb. 3215

TD 3226 5" @ 3226 DD 3229 S/ 3 boph

7 hr. SP 3215 94/ 3193-3211 1 goph

sd-oil-frac P/ 53 bo 67 bw 24 hr.

Comp. 33 bopd 67% wtr.

FABEN GILSTRAP