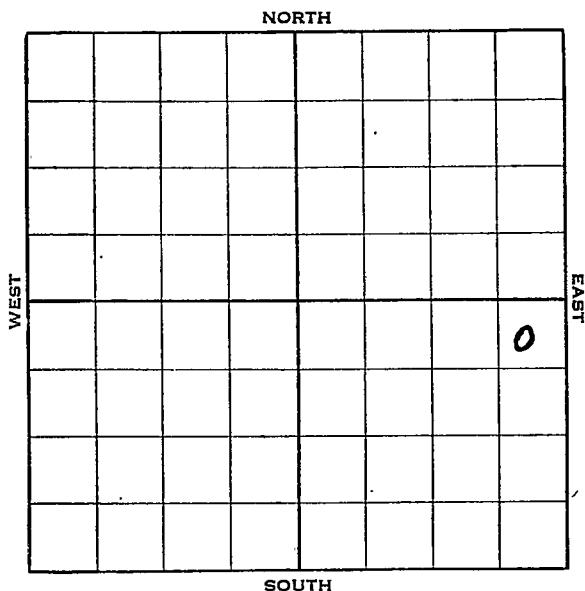


Ellsworth

KANSAS

Section 30 Township 17 Range 9-WWell No. #1 Mollhagen "D"Company Cities Service Oil


KANSAS

Ellsworth

Sec. 30 Twp. 17 R. 9-WWell No. #1 Mollhagen "D" Farm

Cities Service Oil

Company

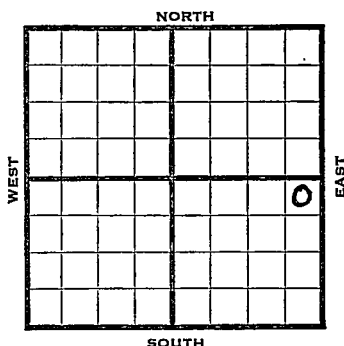440 Ft. from N. Line Ft. from S. Line440 Ft. from E. Line Ft. from W. Line

Elev. 1753'.

1938

REPORT

9/7 Location

9/16 R. U. R.

9/23 10" - 210'. Dlg. 1995'.

9/30 Arb. 3209-10'. Rng. 7".

10/7 7" - 3210'. T.D. 3223'.

400' oil.

10/12 7" at 3210'.

Arb. 3209'.

T. D. 3223'.

500 acid.

Potential 851 bbls.

COMPLETED

Map No. 45 Sec. 30 Twp. 17 R. 9WWell No. 1 Mollhagen "D"Cities Service Oil

Company

Contractor

FIRST REPORT

NE SE

440 Ft. from N. Line Ft. from S. Line440 Ft. from E. Line Ft. from W. Line

SECTION PLAT

			o

Location XRig up

Drilling and Remarks:

RECORD

Cased in., ft.Sand Gas Oil Total Depth

PRODUCTION

1st 24 hrs. Nat. 1st 24 hrs. after shot Gas Cu. Ft.Dry Hole Abandoned

Date

SEP 7 - 1938

19

ORVAL MANNSCHRECK

Scout

Map No. 45 Sec. 30 Twp. 17 R. 9WWell No. 1 Mollhagen "D"Cities Service etal Company

Contractor

COMPLETED

SECTION PLAT

440 NE SE
Ft. from N. Line

Ft. from S. Line

440 Ft. from E. Line

Ft. from W. Line

			0

Location

Rig up

Drilling and Remarks:

500 AcidP.O.T 851

RECORD

Cased 7 in., 3210 ft.Sand Arb 3209

Gas

Oil

Total Depth 3223

PRODUCTION

1st 24 hrs. Nat.

1st 24 hrs. after shot

Gas Cu. Ft.

Dry Hole

Abandoned

Date

OCT 12 1938

19

H. D. Hatfield

Scout