


# KANSAS Ellsworth

Form 51-5M-7-40-Palace

Section 30 Township 17 Range 9-W

Well No. #2 Schroeder

Company Mudge Oil

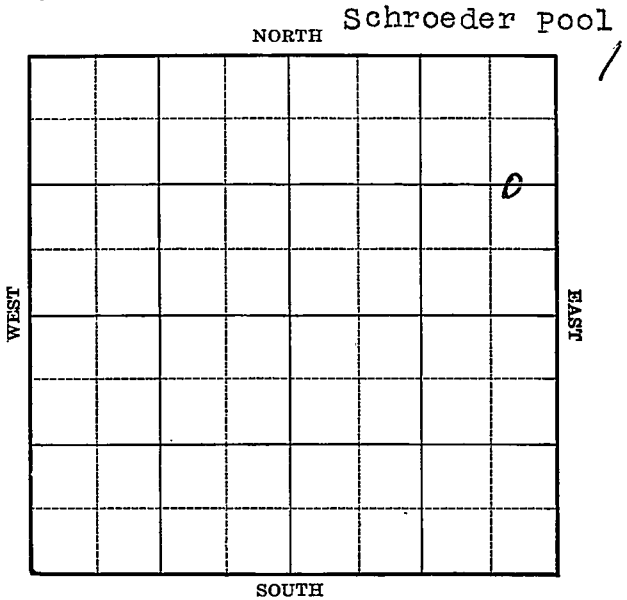

# KANSAS Ellsworth

FORM 252-A 5M 1-41 PETROL

Sec. 30 Twp. 17 R. 9-W

Well No. #2 Schroeder Farm \_\_\_\_\_

Mudge Oil Company \_\_\_\_\_

(Schroeder)


1320 Ft. from N. Line

\_\_\_\_\_ Ft. from S. Line

440 Ft. from E. Line

\_\_\_\_\_ Ft. from W. Line

Elev. 1765

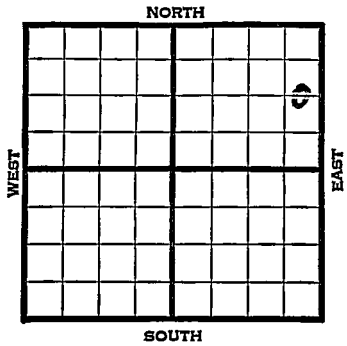

1941

REPORT

5/21

Pits.

5/28

8" - 20.6' Drlg. 1675'

6/5

Arb. 3227-30' T.D. 5" - 3228'  
RUST.

6/12

T.D. 3239' 1700' oil 28 hours.

6/19

" " " "

6/25

Arb. 3227'

5" - 3228'

T.D. 3239'

1000 acid.

Potential 237 bbls., pump.

40.5 Gravity

**COMPLETED**

Map No. 45 Sec. 30 Twp. 17 R. 9W

Well No. 2 Schroeder

Mudge Oil Company

FIRST REPORT Contractor

C E L N E

1320 Ft. from N. Line

\_\_\_\_\_ Ft. from S. Line

440 Ft. from E. Line

\_\_\_\_\_ Ft. from W. Line

SCHROEDER POOL

**SECTION PLAT**


Location \_\_\_\_\_

Rig up \_\_\_\_\_

Drilling and Remarks:  
**Pits**

**RECORD**

Cased \_\_\_\_\_ in., \_\_\_\_\_ ft.

Sand \_\_\_\_\_

Gas \_\_\_\_\_

Oil \_\_\_\_\_

Total Depth \_\_\_\_\_

**PRODUCTION**

1st 24 hrs. Nat. \_\_\_\_\_

1st 24 hrs. after shot \_\_\_\_\_

Gas \_\_\_\_\_ Cu. Ft.

Dry Hole \_\_\_\_\_

Abandoned \_\_\_\_\_

Date

**MAY 21** 1941 19

**S. J. LEWIS** Scout

Map No. 47 Sec. 30 Twp. 17 R. 9WWell No. 2 SchroederMudge Oil

Company

COMPLETED

Contractor

## SECTION PLAT

C E L N E

1320 Ft. from N. Line

\_\_\_\_\_ Ft. from S. Line

440 Ft. from E. Line

\_\_\_\_\_ Ft. from W. Line


SCHROEDER POOL

Location \_\_\_\_\_

Rig up \_\_\_\_\_

Drilling and Remarks:

*Core 3227*  
*5" @ 3228*  
*1000 acc. C*  
*Pump 237 P.S.*  
 " "  
*40 MW*

## RECORD

Cased \_\_\_\_\_ in., \_\_\_\_\_ ft.

Sand \_\_\_\_\_

Gas \_\_\_\_\_

Oil \_\_\_\_\_

Total Depth 3239

## PRODUCTION

1st 24 hrs. Nat. \_\_\_\_\_

1st 24 hrs. after shot \_\_\_\_\_

Gas \_\_\_\_\_ Cu. Ft.

Dry Hole \_\_\_\_\_

Abandoned \_\_\_\_\_

Date

JUN 25 1941 19S. J. LEWIS Scout