

Map No. KANSAS Sec. 30 Twp. 17 S 2 W R. 2Well No. 1-Jackson FarmWyzard Oil Company

NORTH

WEST

								③

EAST

SOUTH

Location.....

Drilling Remarks

Rig Up.....

Drilling Remarks

RECORD

Cased.....in.....ft.

Sand.....

Gas.....

Oil.....

Total Depth.....

PRODUCTION

1st 24 hrs. Nat.....

1st 24 hrs. after shot.....

Gas.....cu. ft.....

Dry Hole.....

Abandoned.....

Map No. Sec. Twp. R.

Well No. Farm


..... Company

..... Ft. from N. Line

..... Ft. from S. Line

..... Ft. from E. Line

..... Ft. from W. Line

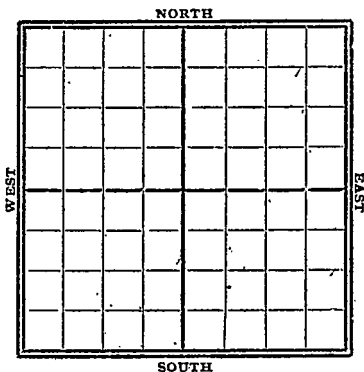

1923

Date

REPORT

Gypsy Records

Mar Abd TD 3112'

MAP No. _____ SEC. 30 TWP. 17S. 2WWELL No. 1 JacksonHighland oil

COMPANY

CONTRACTOR

SECTION PLAT

			0

_____ FT. FROM N. LINE

_____ FT. FROM S. LINE

_____ FT. FROM E. LINE

_____ FT. FROM W. LINE

no Record

LOCATION _____

RIG UP _____

DRILLING AND REMARKS:

nothing
in
files

RECORD

CASED _____ IN. _____ FT.

SAND _____

GAS _____

OIL _____

TOTAL DEPTH 3112

PRODUCTION

1ST 24 HRS. NAT. _____

1ST 24 HRS. AFTER SHOT _____

GAS _____ CU. FT.

DRY HOLE ✓ABANDONED ✓

DATE

Mar. 192 3

SCOUT