

KANSAS


McPherson

FORM 51 5M PETROL

Section 30 Township 17 Range 3W

Well No. #1, Lillian

Company B & R. Drig.
Simon Lobow

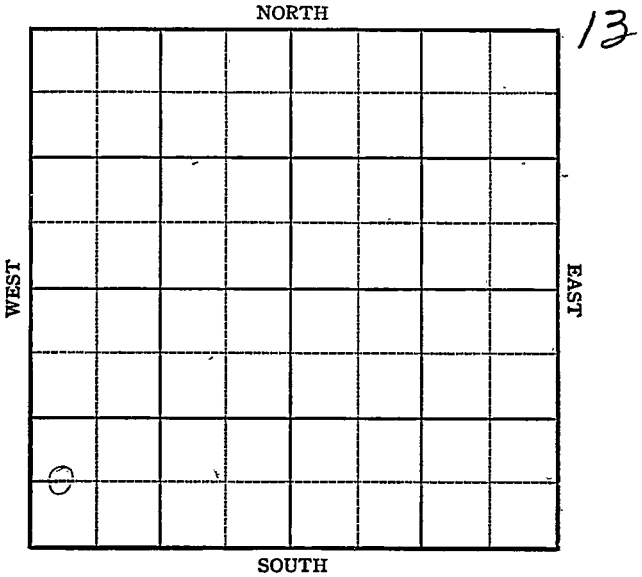

McPherson

KANSAS
Sec. **30**

Twp. **17**

R. **3W**

Well No. **#1 Lillian** Farm

~~Simon Lebow~~ **B + R D L L C** Company

Lindsborg


NORTH

_____ Ft. from N. Line

660 Ft. from S. Line

_____ Ft. from E. Line

330 Ft. from W. Line

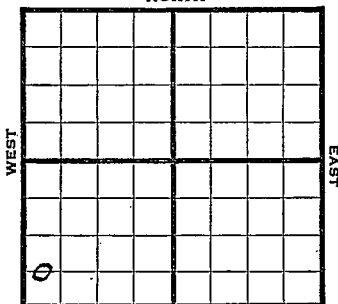

SOUTH

1944

REPORT

5/24	Surface hole.
5/31	" "
6/7	13" @ 155 8" @ 393 Drlg. 2460'
6/15	Miss. 2908 Drlg. 3052
6/21	" "
6/28	Viola 3368 5" @ 3367 TD 3372 400' oil 7 hrs 500 acid
7/12	" " " " " "
7/19	" " " " " "
7/26	" " " " " "
8/2	Viola 3368 5" @ 3367 2000. Acid Pump 82 Pot 36.0 Gravity TD 3372

COMPLETED

KANSASPool Name LindborgMap No. 42 Sec. 30 Twp. 17 R. 3WWell No. 1 LilianSimon Lebow Company**FIRST REPORT**

Contractor

C W L SW SW

SECTION PLAT

o			

 Ft. from N. Line660 Ft. from S. Line Ft. from E. Line330 Ft. from W. LineMcPherson CountyLocation Rig up

Drilling and Remarks:

Surface hole

RECORDCased in., ft.Sand Gas Oil Total Depth **PRODUCTION**1st 24 hrs. Nat. 1st 24 hrs. after shot Gas Cu. Ft.Dry Hole Abandoned

Date

MAY 24 194419S. J. LEWIS Scout

KANSAS

Pool Name Lind sborgMap No. 42 Sec. 30 Twp. 17 R. 3WWell No. I LillianB & R Drlg. Company**CORRECTION** Contractor

C W L SW SW

SECTION PLAT

 Ft. from N. Line660 Ft. from S. Line Ft. from E. Line330 Ft. from W. Line

o			

McPherson CountyLocation Rig up

Drilling and Remarks:

Reported as
Simon Lebow

RECORD

Cased in., ft.Sand Gas Oil Total Depth

PRODUCTION

1st 24 hrs. Nat. 1st 24 hrs. after shot Gas Cu. Ft.Dry Hole Abandoned

Date

MAY 3 1 1944

19

S. J. LEWIS Scout

KANSAS

Pool Name LindsborgMap No. 42 Sec. 30 Twp. 17 R. 3WWell No. 1 LillianB & R Drlg. CompanyCOMPLETED Contractor

C W L SW SW

SECTION FLAT

 Ft. from N. Line660 Ft. from S. Line Ft. from E. Line330 Ft. from W. LineMcPherson CountyLocation Rig up

Drilling and Remarks:

Viola 3368
5" @ 3367
2000 @ 3367
Pump 82 1/2"

36 1/2

RECORD

Cased in., ft.Sand Gas Oil Total Depth 3372

PRODUCTION

1st 24 hrs. Nat. 1st 24 hrs. after shot Gas Cu. Ft.Dry Hole Abandoned

Date

AUG 2 1944 19S. J. LEWIS Scout