KANSAS McPherson

FORM 51 5M 1-42 PETROL


Section 30 Township 17 Range 3-W

Well No. #1 Lilian

Company Winkler & Kock

Lindsborg Pool

12

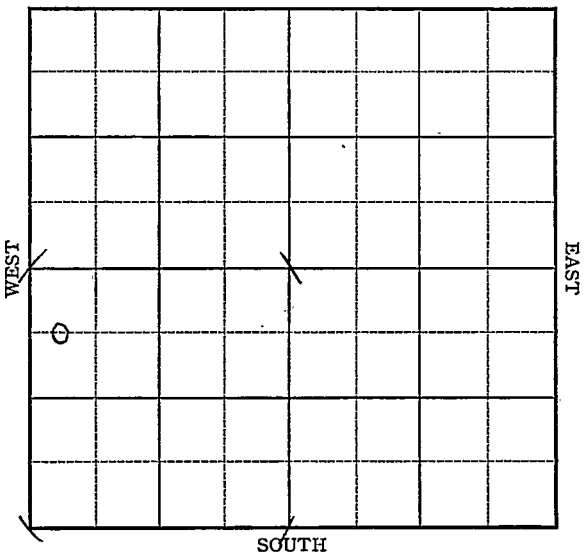

Form 252-A
5M \5-42 Petrol

KANSAS

McPherson

Sec. 30 Twp. 17 R. 3W

Well No. #1 Lilian Farm

Winkler & Kock Company


Lindsborg pool

660 Ft. from N. Line

Ft. from S. Line

Ft. from E. Line

330 Ft. from W. Line

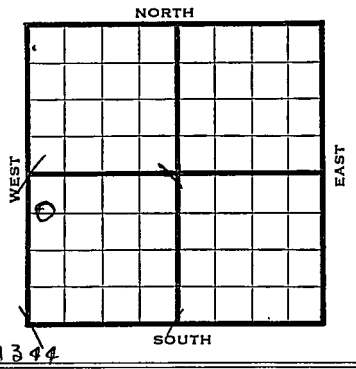

C WL NW SW Elev. 1344

1942	REPORT
11/18	Rotary
11/24	16" @ 200' 10" @ 362' WOC
12/2	Drlg. 2830
12/9	Miss 2914 viola 3360 TD 3362 6" @ 3361 rsut
12/16	" "
12/22	T.D. 3374' 500' oil 9 hrs. 1000 gals. acid Swab 12½ bbls. oil per hr. 3 hrs. off bottom.
12/29	3000 acid TD 3381 stains
1943	
1/6	Viola 3360 6" - 3361 4000 acid Pump 153 oil 8 hrs Pot. 459 Gravity 36. T.D. 3381

COMPLETED

Form 26 200 Bks 5-42 Petroleum

KANSAS

McPherson

Map No. 27 Sec. 30 Twp. 17 R. 3W

Well No. 1 Lilian

Winkler & Koch Company

FIRST REPORT Contractor

C WL NW SW

660 Ft. from N. Line


_____ Ft. from S. Line

_____ Ft. from E. Line

330 Ft. from W. Line

LINDSBORG POOL

SECTION PLAT

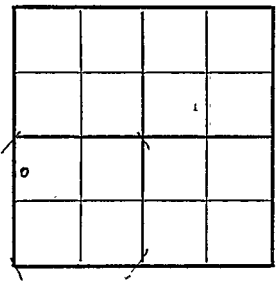

Location _____

Rig up _____

Drilling and Remarks:

Rotary

RECORD

Cased _____ in., _____ ft.

Sand _____

Gas _____

Oil _____

Total Depth _____

PRODUCTION

1st 24 hrs. Nat. _____

1st 24 hrs. after shot _____

Gas _____ Cu. Ft.

Dry Hole _____

Abandoned _____

Date

NOV 18 1942 19

S. J. LEWIS Scout

Form 26 200 Bks 5-42 Petrol

KANSAS

McPherson

Map No. 7 Sec. 30 Twp. 17 R. 3W

Well No. 1 Lilian

Winkler & Koch Company

COMPLETED Contractor

C NL NW SW

660 Ft. from N. Line


_____ Ft. from S. Line

_____ Ft. from E. Line

330 Ft. from W. Line

LINDSBORG POOL

SECTION PLAT

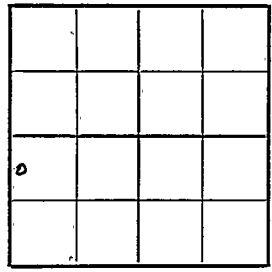

Location

Rig up

Drilling and Remarks:

Viola 3360

L "C 3361

4000 Qual

Pump 153 oil 8 hrs

P & 459

36° Gr.

RECORD

Cased ____ in., ____ ft.

Sand

Gas

Oil

Total Depth 3387

PRODUCTION

1st 24 hrs. Nat.

1st 24 hrs. after shot

Gas ____ Cu. Ft.

Dry Hole

Abandoned

Date

JAN 6 1943 19

S. W. LEWIS Scout