

McPherson


FORM 51

KANSAS

Section 30 Township 17 Range 3W

Well No. #2 Lillian

Company Eldorado Ref.

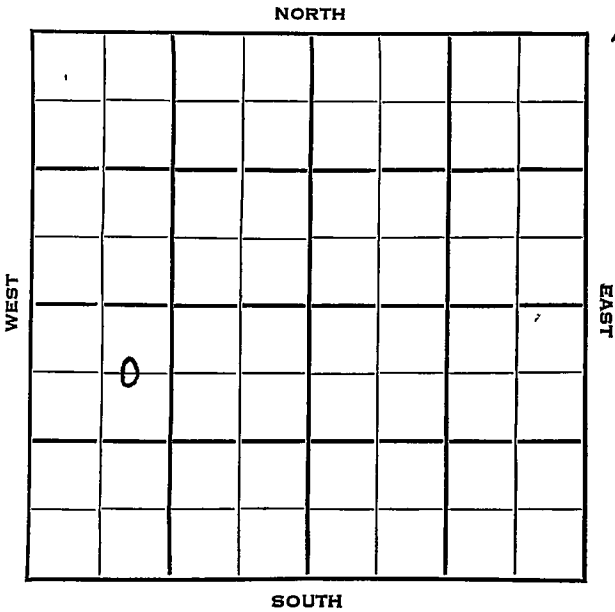

McPherson KANSAS


| | | |
|------|------|------|
| SEC. | TWP. | R. |
| 30 | 17 | 3W ✓ |

WELL NO. 2 Lillian FARM
COMPANY

El Dorado Ref.
CONTRACTOR

Sterling Drlg.
Lindsborg Pool

660 Ft. from N. Line
Ft. from S. Line
Ft. from E. Line
990 Ft. from W. Line

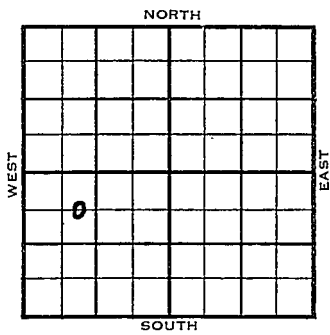

C E L NW SW

| | ELEVATION | REPORT |
|------|-----------|--------|
| 1954 | 1349' | |

3/3 Location
3/10 13" @ 81' w/125 sks
8" @ 412' w/200 sks
WOC
3/17 Drlg. 3023'
3/24 Spud 3-6-54
B&A
TD 3572'
13" @ 81'
8" @ 412'
Miss 2904', Kh 3154', Mar. 3367'
DST 3367-72', opn 1 hr., rec. 20' mud,
215#
Simp. 3483', Arb. 3556'
TD 3572'
D&A

ABANDONED

County McPherson State KansasSec. 30 (Blk.
Twp.) 17 (Sur.
Rge.) 3W Map No.Operator Eldorado Ref.Well No. 2 Farm LillianElev. 1349 Location C E L NW SW

| | | | | | | | | | |
|-----------|--|--|--|--|--|--|--|--|--|
| ABANDONED | | | | | | | | | |
| | | | | | | | | | |
| | | | | | | | | | |
660 Ft. From N Line SW990 Ft. From W Line Quarter

1st. Report

Completion MAR 24 1954Remarks Lindsborg PoolSterling Drlg. - Contr.Spudding Date 3-6-54Drlg. Data D & A TD 357213" @ 81 8" @ 412 Miss. 2904 Kh. 3154Mar. 3367 DST 3367-72 open 1 hr.Rec. 20' mud 215# Simp. 3483Arb. 3556 TD 3572D & A

J. G. McGEHEE