
McPherson Co. KANSAS

FORM 51 10M 8-47

Section 30 Township ~~14~~ 17 Range 1W

Well No. 2 Bishop

Company Westgate-Greenland

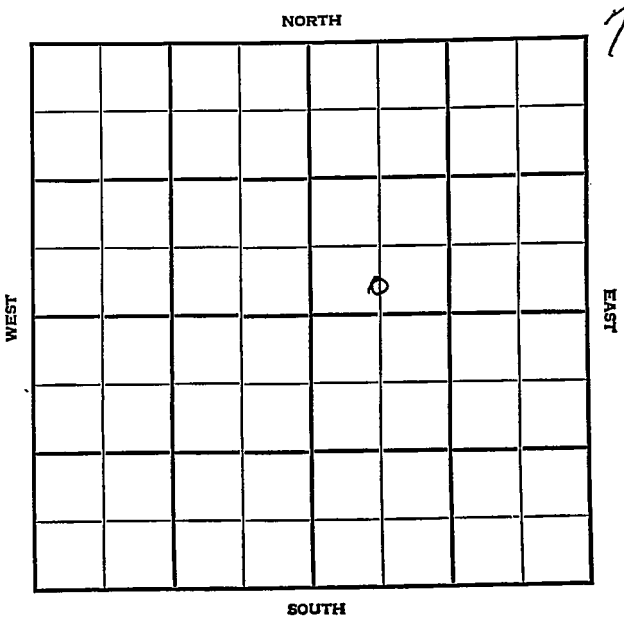

FORM 252-A
5M 9-47 PETROL

KANSAS McPherson ✓

Sec. 30 Twp. 17 R. 1W

Well No. #2 Bishop Farm

Westgate-Greenland Company

Crowther


Ft. from N. Line

330 Ft. from S. Line

Ft. from E. Line

660 Ft. from W. Line

C SL SW NE

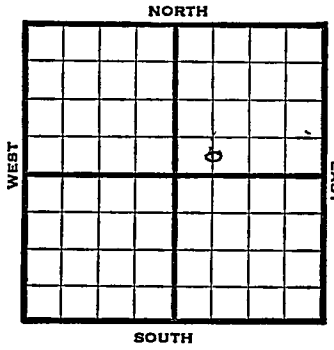

	REPORT
1947	Elev. 1368'
12/17	Location
12/30	10" @ 152' Mississippi 2684-86' TD 5" @ 2684' RUST
1948 1/7	"
1/14	"
1/21	TD 2695' 1000 Acid Estimate 8 bbls oil / 4 W PH
1/28	Miss. 2684' 5" @ 2684' 1000 acid Pump 202 Oil / 37 % W Pot 36.7 Gr. TD 2695' Comp.

COMPLETED

Form 26 200 Bks. 10-46 Petrol
Kansas

Crowther Pool

Map No. ____ Sec. 30 Twp. 17 R. 1W


Well No. 2 Bishop

Westgate-Greenland Company

FIRST REPORT Contractor

C S L SW NE

SECTION PLAT

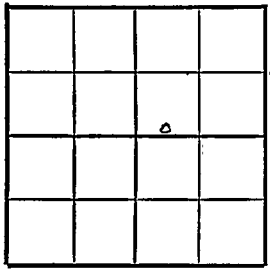

____ Ft. from N. Line

330 Ft. from S. Line

____ Ft. from E. Line

660 Ft. from W. Line

McPherson County

Location X

Rig up

Drilling and Remarks:

RECORD

Cased ____ in., ____ ft.

Sand

Gas

Oil

Total Depth

PRODUCTION

1st 24 hrs. Nat.

1st 24 hrs. after shot

Gas ____ Cu. Ft.

Dry Hole

Abandoned

Date

DEC 17 1947 19____ S. J. LEWIS Scout

Form 26 200 Bks. 10-46 Petrol

Kansas

Crowther Pool

Map No. 42 Sec. 30 Twp. 17 R. 1W

Well No. 2 Bishop

Westgate-Greenland Company


COMPLETE

Contractor

C S L SW NE

E 1,1368

SECTION PLAT

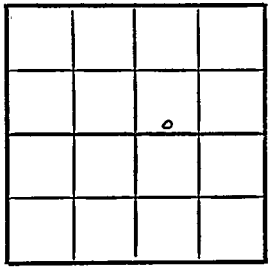

____ Ft. from N. Line

330 Ft. from S. Line

____ Ft. from E. Line

660 Ft. from W. Line

McPherson County

Location

Rig up

Drilling and Remarks:

Miss 2684

5" @ 2684

1000 acid

Pump 202 oil

85% Gr

RECORD

Cased ____ in., ____ ft.

Sand

Gas

Oil ✓

Total Depth 2685

PRODUCTION

1st 24 hrs. Nat.

1st 24 hrs. after shot

Gas ____ Cu. Ft.

Dry Hole

Abandoned

Date

JAN 28 1948

19

S. J. LEWIS Scout